

Stafford


KANSAS .

FORM 51

Section 26 Township 21 Range 12W

Well No. #1 Widener

Company Laura Jane Friedman Putzy

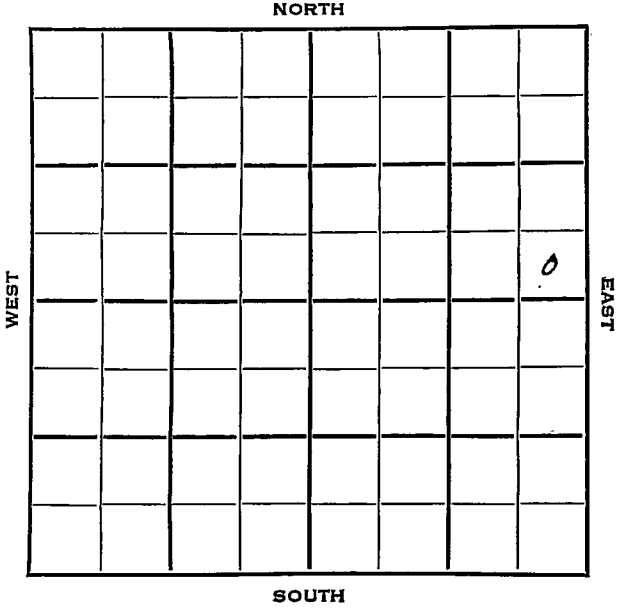

SEC. 26	TWP. 21	R. 12W	✓
------------	------------	-----------	---


WELL NO. #1 Widener FARM

COMPANY FRIEDMAN TRUSTY
Laura Jane

CONTRACTOR

Wildcat

Ft. from N. Line
330 Ft. from S. Line
330 Ft. from E. Line
Ft. from W. Line

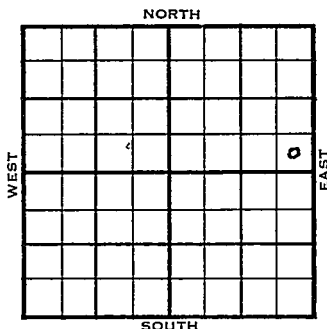

SE SE NE Texas - DHM

1954	ELEVATION	REPORT
	1825'	
		Arb. Test.
2/10		Spud 2-6-54 8" @ 326' Drlg 1945'
2/17		Heeb 3095', Br li 3222', Lans 3238', V 3500' DST 3505-23, 1/2 hrs., 6' M Off Arb. 3572' DST 3574-81', 1 1/4 hrs., 2580' gas, 300' oil, 75' frothy oil, 1030# TD 3581', log 7" @ 3573'
2/24		CO 3581', S/5 boph nat.
3/3		NR
3/10		NR
3/17		"
3/24		NR
4/14		Spud 2-6-54 - Oil Well TD 3581' 8" @ 326' Heeb 3095', Br lime 3222', Lans 3238', Viola 3500' DST 3505-23', opn 1/2 hr., rec. 6' mud, Off Arb. 3572'

(Information Brought Forward)

1954
4/14

DST 3574-81', opn 1 $\frac{1}{4}$ hrs., rec.
2580' gas, 300' oil, 75' foathy
oil, 1030#

TD 3581'

7" @ 3573'

CO to 3581'

S/5 boph

P/100 bopd

Comp. 88 bopd

COMPLETED

FEB 11 1974

For : Cards
.....
.....
Trachies
.....
.....
.....
Misc.

Orig. Date

County Stafford State Kansas

Sec. 26 (Blk. 21) (Sur. 12W) (Twp. 21) (Rge. 12W) Map No.

Operator Friedman & Autry

Well No. 1 Farm Widener

Elev. 1825 Location SE SE NE

330 Ft. From S Line NE

330 Ft. From E Line Quarter

1st. Report

Completion APR 14 1954

Remarks Wildcat

H.M. Williams - Contr.

Spudding Date 2-6-54

Drlg. Data Oil well TD 3581

8" @ 326 Heeb. 3095 Br. lime 3222

Lans. 3238 Viola 3500 DST 3505-23

open 1/2 hr. Rec. 6' mud 0# Arb. 3572

DST 3574-81 open 1 1/2 hr. Rec. 2580' gas

300' oil 75' frothy oil 1030#

TD 3581 7" @ 3573 CO to 3581

S/ 5 boph P/ 100 bopd Comp. 88 bopd

COMPLETE

APR 20 1954

Scout Cards	_____
Land Small Map	_____
Land Wall Map	_____
Trailings	_____
France map	_____
Pierre Map	_____
Misc.	_____