


DX 78-1

Stafford KANSAS

Section 26 Township 21 Range 12W

Well No. 3 Wiedner

Company Friedman & Autrey

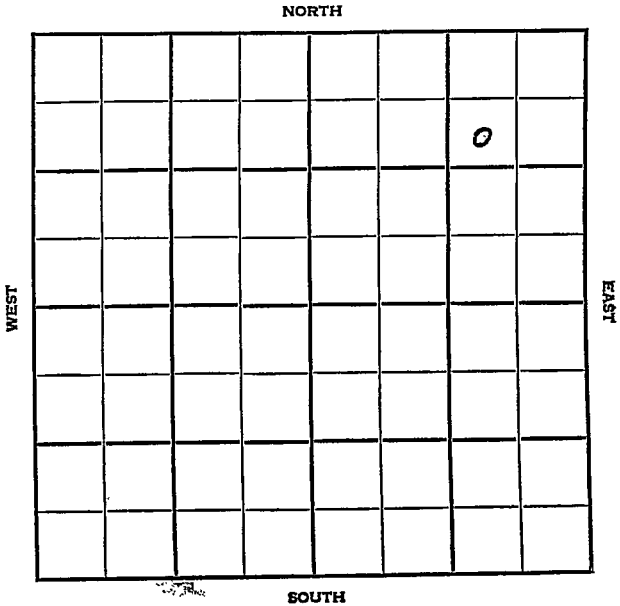

Stafford

KANSAS

SEC.	TWP.	R.
26	21	12W

WELL NO.

#3 Wiedner

FARM

COMPANY

Friedman & Autrey

CONTRACTOR

K & E Drlg.

Wiedner Pool


990 Ft. from N. Line

Ft. from S. Line

990 Ft. from E. Line

Ft. from W. Line

SW NE NE

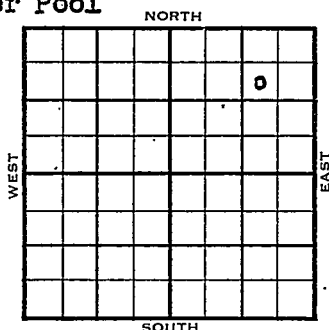

	ELEVATION	REPORT
1954	1836'	

9/1 Spud 8-30-54
8" @ 293'
Anhy 610'
Drlg. 1700'

10/6 Spud 8-30-54
Oil Well
TD 3623'
8" @ 293'
Anhy 610', Heeb 3102', Br. Lime 3229
Lans 3245', Viola 3520', Simp 3555'
Arb. 3605'
DST 3606'-13' opn 1 hr, rec 10' Mud,
20#
DST 3610'-23' opn 1 hr, rec 120' ho &
gcm 850#
TD 3623'
5" @ 3607'
CO to 3623'
S/ 10 bopd. sd-frac. S/ 3 boph 4 hr.
Comp 67 bopd.

COMPLETED

County **Stafford** State **Kansas**

Sec. 26 (Blk. Twp.) 21 (Sur. Rge.) 12W Map No.

Operator **Friedman & Autrey**

Well No. **3** Farm **Wiedner**

Elev.	1836	Location	SW NE NE
-------	------	----------	----------

0

FIRST REPORT

990 Ft. From **N** Line **NE**

990	Ft. From	E	Line	Quarter
-----	----------	---	------	---------

1st. Report SEP 1 1954

Completion

Remarks

K & E Dr'g. - Contr.

Spudding Date **8-30-54**

Drig. Data Wiedner Pool

8" @ 293 Anhy 610 drlg. 1700

FABEN GILSTRAP

County Stafford State Kansas

Sec. 26 (Blk. 21 (Sur. 12W Map No.

Operator Friedman & Autrey

Well No. 3 Farm Widener

Elev.	1836	Location	SW SE NE
-------	------	----------	----------

COMPLETE

990 Ft. From N Line NE

990 Ft. From E Line Quarter

1st. Report

Completion OCT 6 1954

Remarks Widener Pool

K & E Drlg. = Contr.

Spudding Date 8-30-54

Drilg. Data Oil well TD 3623

8" @ 293 Anhv 610 Heeb. 3102

Br. lime 3229 Lans. 3245 Viola 3520

Simp. 3555 Arb. 3605 DST 3606-13

open 1 hr. Rec. 10' mud 20[#]/₂ DST 3610-

23 open 1 hr. Rec. 120' ho & gcm

850# TD 3623 5" @ 3607 CO to 3623

S/ 10 bopd sd-frac S/ 3 boph 4 hr.

Comp. 67 bopd

FABEN GILSTRAP