

Stafford

KANSAS

Section **26** Township **21** Range **13W**

Well No. #1 Fanshire "A"--

Company Nadel & Gussman

NORTH

WEST

EAST

SOUTH

Sec. 26 Twp. 21 R. 13-W

Well No. #1 Fanshire (A) Farm

Nadel & Gussman Company

Peel Contractor

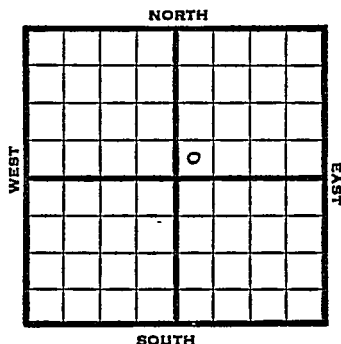
 Ft. from N. Line

330 Ft. from S. Line

 Ft. from E. Line

330 Ft. from W. Line

SW SW NE



1950

Elev 1873

REPORT

6/7

Spud 6-4-50

8" @ 322

W.O.C.

6/14

8" @ 322

Anhy 715-45

Lans. 3334

DST 3445-60

opn 30 min, rec 60' sw

Cong 3571

TD 3740

D&A

ABANDONED

Map No. _____ Sec. 26 Twp. 21 R. 13W

Well No. 1 Fanshire (A)

Nadel & Gussman _____ Company

Peel _____ Contractor

SW SW NE

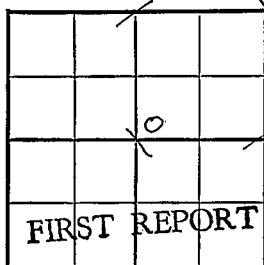
_____ Ft. from N. Line

330 _____ Ft. from S. Line

_____ Ft. from E. Line

330 _____ Ft. from W. Line

SECTION PLAT

*Stafford*

Location _____

Rig up _____

Drilling and Remarks:

Spud 6-4-50

8" @ 322

W. O. C.

RECORD

Cased _____ in., _____ ft.

Sand _____

Gas _____

Oil _____

Total Depth _____

PRODUCTION

1st 24 hrs. Nat. _____

1st 24 hrs. after shot _____

Gas _____ Cu. Ft.

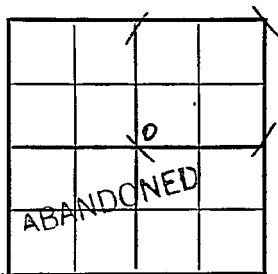
Dry Hole _____

Abandoned _____

Date

JUN 7 1950 19 I E TVPA Scout

Kansas

Map No. _____ Sec. 26 Twp. 21 R. 13WWell No. 1 Fanshire "A"_____Nadel & Gussman_____
Company_____
ContractorS⁷ S⁷ NEE1. 1873
SECTION PLAT_____
Ft. from N. Line330 Ft. from S. Line_____
Ft. from E. Line330 Ft. from W. Line

Stafford County

Location _____

Rig up _____

Drilling and Remarks:

8" @ 322

Anhy 715-45

Lans. 3334

DST 3445-60

open 30 min.

Rec. 60' sw

Cong. 3571

ID 3740

RECORD

Cased _____ in., _____ ft.

Sand _____

Gas _____

Oil _____

Total Depth 3740

PRODUCTION

1st 24 hrs. Nat. _____

1st 24 hrs. after shot _____

Gas _____ Cu. Ft.

Dry Hole _____

Abandoned _____

Date B & AJUN 14 1950 19 J. E. TYRA Scout