


Section 26 Township 21 Range 13 W  
Well No. # 3 Batman "A"  
Company Armer

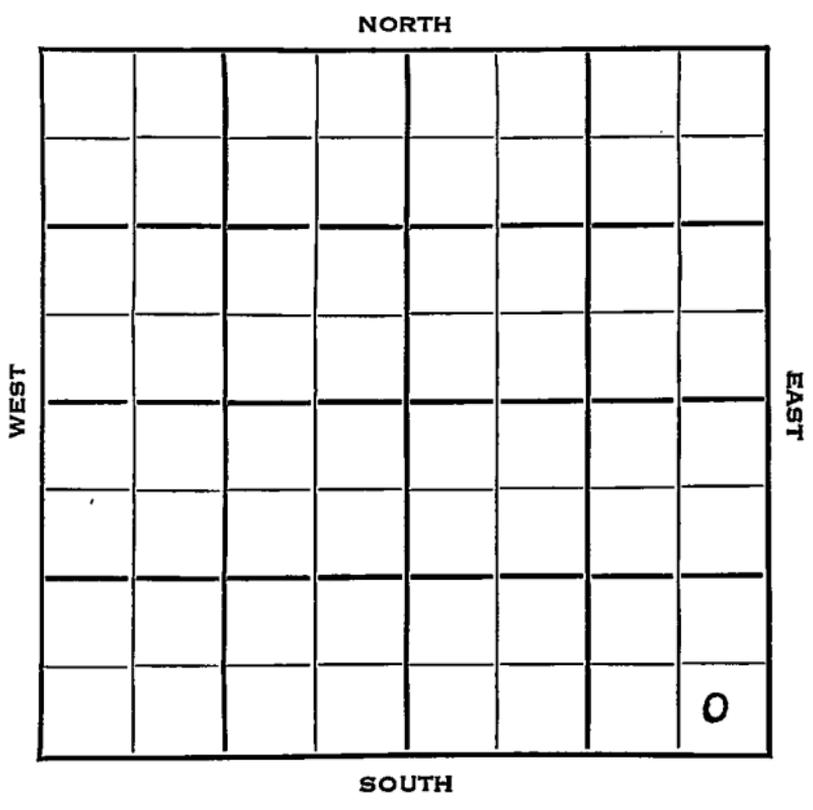

Sec. 26 Twp. 21 R. 13W

Well No. #3 Batman "A" Farm \_\_\_\_\_

Armer Company

Armer Contractor

NW Fischer Pool


\_\_\_\_\_ Ft. from N. Line

330 Ft. from S. Line

330 Ft. from E. Line

\_\_\_\_\_ Ft. from W. Line

SE SE SE

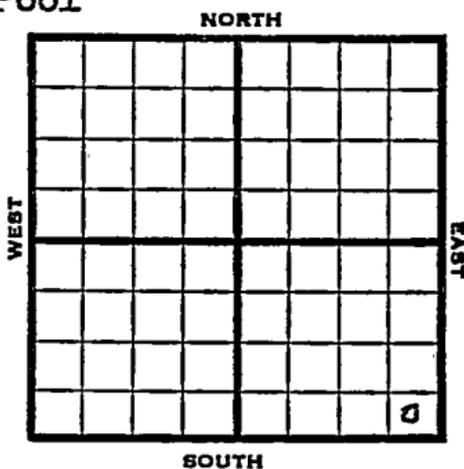

1953 Elev. 1875' REPORT

6/3 Spud 6-1-53  
8" @ 267'  
DrIg 705'

6/10 Anhy 700 Br li 3290 Lans 3308  
DrIg. 3500

7/8 5" @ 3651'

7/22 Spud 6-1-53  
Oil Well  
TD 3665  
8" @ 267'  
Anhy 700, Br lime 3290, Lans 3308,  
Arb. 3655  
DST 3655-65, opn 18 mins., gas in 10  
mins., rec. 2460' oil 690#  
TD 3665  
5" @ 3651  
DST 3428-39, opn 1 hr., rec. 780' gas,  
30' gcm, 350#  
CO to 3665  
S/55 boph  
Comp. 408 bopd

COMPLETED



