


Section 26 Township 21 Range 13W

Well No. 3 1/2 #1 D. Smith

Company M.B. Armer

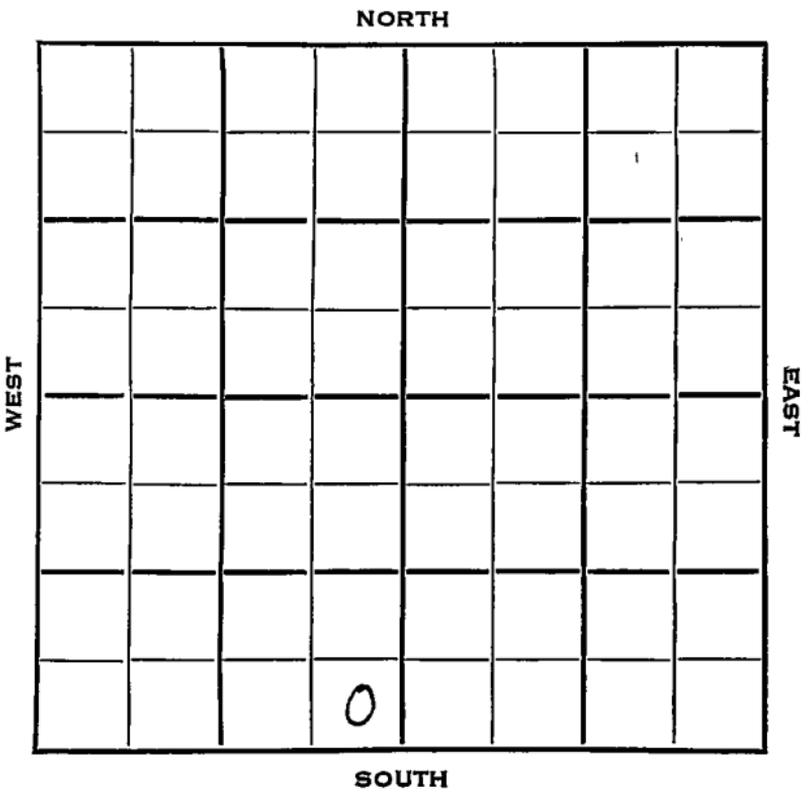

Stafford

KANSAS ✓

Sec. 26 Twp. 21 R. 13W

Well No. #1 D. Smith Farm

M. B. Armer Company

Armer Contractor

Gates Pool


 Ft. from N. Line

330 Ft. from S. Line

330 Ft. from E. Line

 Ft. from W. Line

SE SE SW

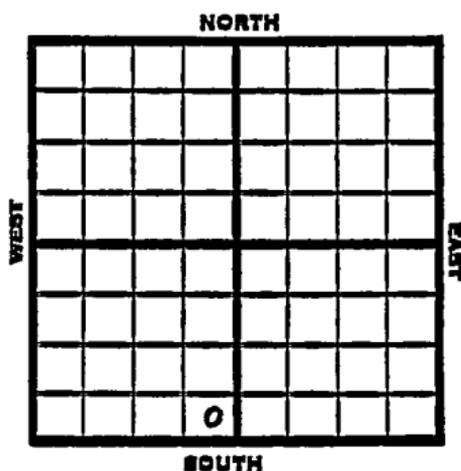

1953 Elev. 1872' REPORT

8/12 MIR
 8/19 8" @ 270'
 Drlg. 2765'

8/26 Br li 3296 Lans 3314'
 DST 3330-92, 1 hr, gas in 5", 65'
 GCM, 670' MCO 1145#
 DST 3420-45, 1 hr, 60' GCM 1230#
 V 3564 Simp 3605 Arb 3653'
 DST 3655-65, 1 hr, 600' oil 462#
 RTD 3566 5" @ 3655

9/2 CO 3666 S/ 8 boph 500 A S/ 11 boph
 5 Hrs. POP

9/9 Spud 8-11-53
 OilWell
 TD 3666'
 8" @ 270'
 Br. lime 3296, Lans 3314,
 DST 3330-92, opn 1 hr., gas in 5",
 rec. 65' gcm, 670' mco, 1145#
 DST 3420-45, opn 1 hr., rec. 60'
 gcm, 1230#
 Viola 3564, Simp 3605, Arb. 3653
 DST 3655-65, opn 1 hr., rec. 600' oil
 462#
 TD 3666
 5" @ 3655
 CO to 3666, S/8 boph, 500A, S/17 boph

OVER

(Information Brought Forward)

1953

9/9

Comp. 50 bopd

COMPLETED

AUG 14 1953

Scout Cards	<i>Ad</i>
Tracings	<i>3</i>
France Map	
Pierce Map	
Misc.	

Kansas

Map No. _____ Sec. 26 Twp. 21 R. 13W

Well No. 2 D. Smith

M. B. Armer _____ Company

CORRECTION

Contractor

SE SE SW

SECTION PLAT

_____ Ft. from N. Line

330 Ft. from S. Line

330 Ft. from E. Line

_____ Ft. from W. Line

Stafford County

Location _____

Rig up _____

Drilling and Remarks:

Reported
#4 Smith

RECORD

Cased _____ in., _____ ft.

Sand _____

Gas _____

Oil _____

Total Depth _____

PRODUCTION

1st 24 hrs. Nat. _____

1st 24 hrs. after shot _____

Gas _____ Cu. Ft.

Dry Hole _____

Abandoned _____

Date

SEP 2 1953
19

J. G. McGEHEE Scout

SEP 4 1953

Scout Cards	_____	<i>10</i>
Land Small Map	_____	
Land Wall Map	_____	
Tracings	_____	
France Map	_____	<i>13</i>
Pierce Map	_____	
Misc.	_____	

Map No. _____ Sec. 26 Twp. 21 R. 13W

Well No. 3 D. Smith

M. B. Armer Company

Contractor

SE SE SW

CORRECTION


SECTION PLAT

_____ Ft. from N. Line

330 Ft. from S. Line

330 Ft. from E. Line

_____ Ft. from W. Line

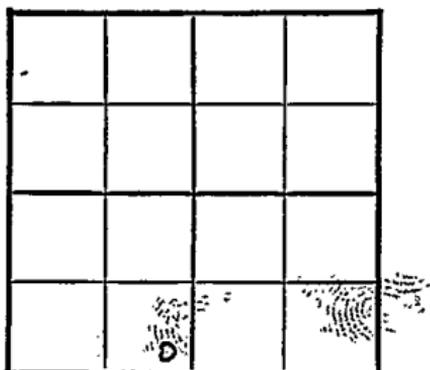

Stafford County

Location _____

Rig up _____

Drilling and Remarks:

**Recorrected
from
#2 Smith**

RECORD

Cased _____ in., _____ ft.

Sand _____

Gas _____

Oil _____

Total Depth _____

PRODUCTION

1st 24 hrs. Nat. _____

1st 24 hrs. after shot _____

Gas _____ Cu. Ft.

Dry Hole _____

Abandoned _____

Date

SEP 9 1953

19

J. G. McGEHEE

Scout

SEP 11 1953

Scout Cards	_____	<i>Ad</i>
Land Small Map	_____	
Land Wall Map	_____	<i>3P</i>
Tracings	_____	
France Map	_____	
Pierce Map	_____	
Misc.	_____	

SEP 15 1953

Scout Cards	_____
Land Small Map	_____
Land Wall Map	_____
Tracings	_____
France Map	_____
Pierce Map	_____
Misc.	_____

Drig. Date