

Section 26 Township 21 Range 11WWell No. #1 WhiteCompany J. J. Lynn

NORTH

0							

WEST

EAST

SOUTH

Stafford

KANSAS

Sec. 26 Twp. 21 R. 11W ✓

Well No. #1 White Farm

J. J. Lynn Company

Sterling Drlg. - Contr. Contractor


Wildcat
Ft. from N. Line

330' Ft. from S. Line

Ft. from E. Line

330' Ft. from W. Line

SW SW NW

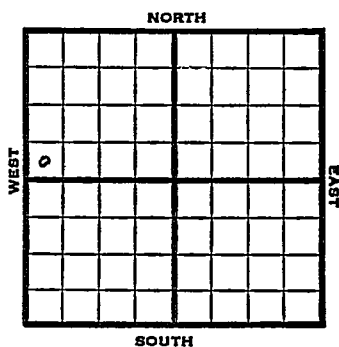

1951 Elev. 1863' REPORT

4/25 Spud 4-19-51
8" @ 280
Drlg. 1732'

5/9 Spud 4-19-51
D&A TD 3520
8" @ 280
Lans. 3112 Cong. 3386
Viola 3395'
DST 3373-3414 opn 1/2 hr
Rec. 10' mud
DST 2983-93 opn 1 hr
Rec. 110' mud & SS0
DST 3420-35 opn 1 hr.
Rec. 30' mud
Arb. 3478' TD 3520


ABANDONED

County **Stafford** State **Kansas**Sec. **26** (Blk.) **21** (Sur.) **11W** Map No.Operator **J. J. Lynn**Well No. **1** Farm **White**Elev. Location **SW SW NW**

FIRST REPORT**330** Ft. From **S** Line **NW****330** Ft. From **W** Line Quarter1st. Report **APR 25 1951**

Completion

Remarks **Stanolind farmout****Sterling Drlg. - Contr.**Spudding Date **4-19-51**Drlg. Data **Wildcat****8" @ 280 drlg. 1732****J. E. TYRA**

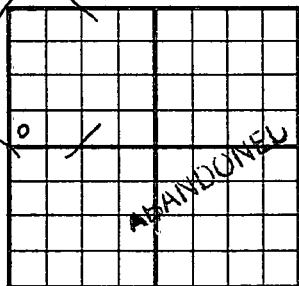County Stafford State KansasSec. 26 (Blk. 21 (Sur. 11W Map No.)
(Twp.) (Rge.)Operator J. J. LynnWell No. 1 Farm WhiteElev. 1863 Location SW SW NW330 Ft. From S Line NW330 Ft. From W Line Quarter1st. Report Completion MAY 9 1951Remarks WildcatSterling Drlg. - Contr.Spudding Date 4-19-51Drlg. Data D & A TD 35208" @ 280 Lans. 3112 Cong. 3386Viola 3395 DST 3373-3414 open $\frac{1}{2}$ hr.Rec. 10' mud DST 2983-93 open 1 hr.Rec. 110' mud & SSO DST 3420-35 open1 hr. Rec. 30' mud Arb. 3478 TD 3520D & A

J. E. TYRA