

Section 26 Township 21 Range 16W

Well No. #1 Goldie

Company Carl Todd

NORTH

0							

WEST

EAST

SOUTH

HOT FILE

Pawnee

KANSAS

SEC.	TWP.	R.
26	21	16 W

WELL NO. # 1 Goldie FARM

COMPANY
 Contractor Carl Todd

Co. tools
 Larned Pool


_____ Ft. from N. Line

990 _____ Ft. from S. Line

_____ Ft. from E. Line

330 _____ Ft. from W. Line

NW SW NW

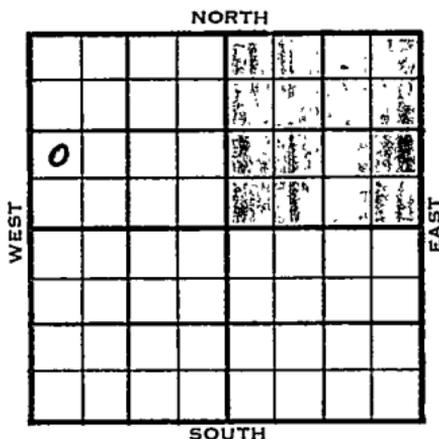

Sunray FO

	ELEVATION	REPORT
1955	1981'	
1/12	Spud 1-5-55 8" @ 980 Drlg. 2500'	
1/20	Heeb 3383', Br. Lm 3484', Lans 3494' B-KC 3730', Shy Cong 3774', Cherty Cong 3779' DST 3792-3820, 1 hr, 30' mud. BHP 160# 20". Wea. Simp. 3838', Simp 3850', Arb. 3881' DST 3882-85, 1 hr, 55' muddy water. BHP 1050# 20". DST 3885-90, 1 hr, 70' muddy water w/sulphur odor. BHP 1050# 20". RTD 3903' No Log. D & A. (Ltr-Gilstr)	
1955 1/19	Spud 1-5-55 - D&A TD 3903' 8" @ 980' Heeb. 3383', Br lime 3484', Lans 3494' B KC 3730', Cong. 3774', Ch Cong 3779' DST 3792-3820', opn 1 hr., rec. 30' mud, 160# WeSimp. 3838', Simp. 3850', Arb. 3881' DST 3882-85', opn 1 hr., rec. 55' MW, 1050# DST 3885-90', opn 1 hr., rec. 70' MW, 1050# TD 3903' - D&A	

DX-78

ABANDONED


County **Pawnee** State **Kansas**

Sec. **26** (Blk. Twp.) **21** (Sur. Rge.) **16W** Map No.

Operator **Carl Todd**

Well No. **1** Farm **Goldie**

Elev. Location **NW SW NW**

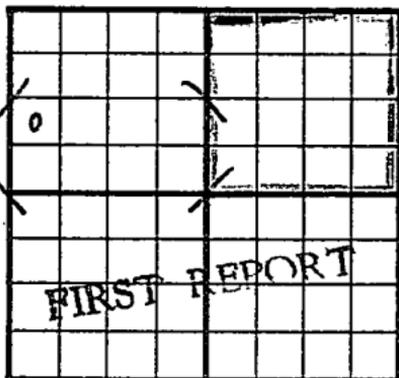

990 Ft. From **S** Line **NW**

330 Ft. From **W** Line Quarter

Ist. Report **JAN 12 1955**

Completion

Remarks **Sunray Permout**
Co. tools

Spudding Date **1-5-55**

Drlg. Data **Larned Pool**

8" @ 980 drlg. 2500

FABEN GILSTRAP


County Pawnee State Kansas

Sec. 26 (Blk. Twp.) 21 (Sur. Rge.) 16W Map No.

Operator Carl Todd

Well No. 1 Farm Goldie

Elev. 1981 Location NW SW NW

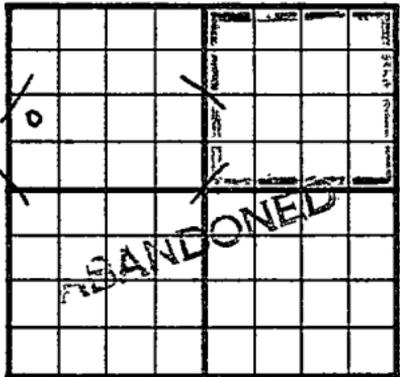

990 Ft. From S Line NW

330 Ft. From W Line Quarter

1st. Report

Completion JAN 19 1955

Remarks Larned Pool

Co. tools

Spudding Date 1-5-55

Drlg. Data D & A TD 3903

8" @ 980 Heeb. 3383 Br. lime 3484

Lans. 3494 B KC 3730 Cong. 3774

Ch. Cong. 3779 DST 3792-3820 open 1 hr.

Rec. 30' mud 160# WeSimp. 3838

Simp. 3850 Arb. 3881 DST 3882-85

open 1 hr. Rec. 55' mw 1050#

DST 3885-90 open 1 hr. Rec. 70' mw

1050# TD 3903

D & A