

KANSAS

FORM 51 5M 4-41 PETROL

Section 26 Township 21 Range 17-W

Well No. 1 Wilson

Company Helmerich & Payne


NORTH								Wildcat
WEST								
								0
SOUTH								

KANSAS

Pawnee

Sec. 26 Twp. 21 R. 17-WWell No. #1 Wilson FarmHelmerich & Payne Company
(Wildcat)330 Ft. from N. Line Ft. from S. Line330 Ft. from E. Line Ft. from W. Line

Elev. 2056

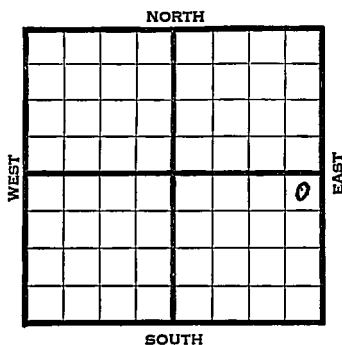

1941

REPORT

9/17

Rotary.

9/25

Anhy 1073' 8" - 800'

Drlg. 2170'

10/2

Lans. 3584' Cong. 3922'

Arb. 3977' Drlg. 4000' No

shows.

10/8

Arb. 3972'

T.D. 4032'

No shows.

ABANDONED

Pawnee

KANSAS

Map No. 81 Sec. 26 Twp. 21 R. 17WWell No. 1 WilsonHelmerich & Payne Company

Contractor

FIRST REPORT

NE SE

330 Ft. from N. Line Ft. from S. Line330 Ft. from E. Line Ft. from W. Line

SECTION PLAT

			o

WILDCAT

Location Rig up

Drilling and Remarks:

Rotary

RECORD

Cased in., ft.Sand Gas Oil Total Depth

PRODUCTION

1st 24 hrs. Nat. 1st 24 hrs. after shot Gas Cu. Ft.Dry Hole Abandoned

Date

SEP 17 1941

19

S. J. LEWIS Scout

Map No. K-81 Sec. 26 Twp. 21 R. 17WWell No. 1 WilsonHelmerich & Payne

Company

ABANDONED

Contractor

Moody

NE SE

SECTION PLAT

			o

330 Ft. from N. Line Ft. from S. Line330 Ft. from E. Line Ft. from W. Line

WILDCAT

Location Rig up

Drilling and Remarks:

CR 8972No shows

RECORD

Cased in., ft.Sand Gas Oil Total Depth 4032

PRODUCTION

1st 24 hrs. Nat. 1st 24 hrs. after shot Gas Cu. Ft.Dry Hole Abandoned

Date

OCT 8 1941 19S. J. LEWIS Scout