


Section 26 Township 21 Range 34W

Well No. #2 Davis

Company Atlantic

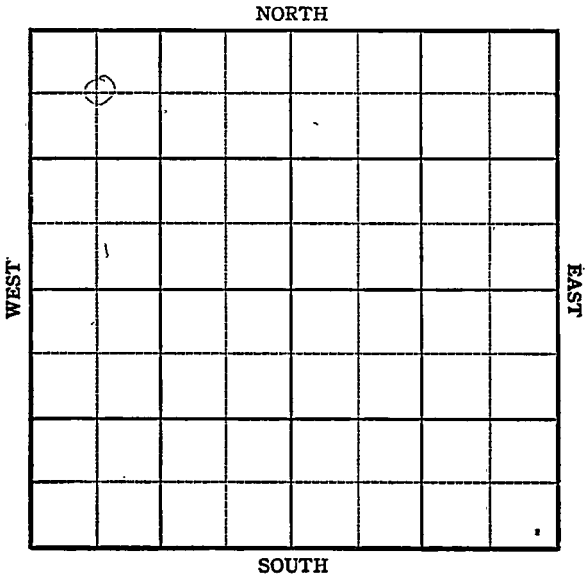

Sec. 26 Twp. 21 R. 34-W

Well No. #2 Davis Farm

Atlantic Company


(Nunn)

660 Ft. from N. Line

_____ Ft. from S. Line

_____ Ft. from E. Line

660 Ft. from W. Line

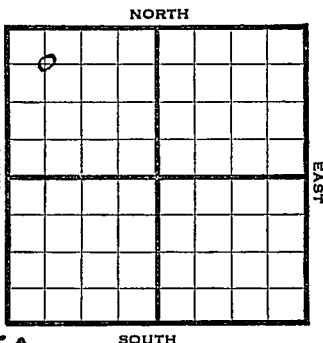

Elev. 2950

1944

REPORT

5/17	Location
5/24	Rotary
5/31	10" @ 245 Drlg. 600
6/7	Drlg. 3150'
6/15	Drlg. 3835'
6/21	Drlg. 4485'
6/28	Miss 4610-75 TD SO Lans 3850 T u n csg
7/12	TD 4675 1000 acid 1200 oil in 8 hrs
7/19	" " " " " " " " " "
7/26	" " " " " " " " " "
8/2	" " " " " " " " " "
8/9	8000 acid Pump 15 oil per hr.
8/16	Miss 4610 5" @ 4614 TD 4675 Acid 9000 Pump 462 oil & 2% water Gravity 27.0

COMPLETED

KANSASPool Name NunnMap No. N M Sec. 26 Twp. 21 R. 34WWell No. 2 DavisAtlantic Company**FIRST REPORT** Contractor

C NW NW

SECTION PLAT

660 Ft. from N. Line Ft. from S. Line Ft. from E. Line660 Ft. from W. Line

o			

Finney County

RECORD

Location XRig up

Drilling and Remarks:

Cased in., ft.Sand Gas Oil Total Depth

PRODUCTION

1st 24 hrs. Nat. 1st 24 hrs. after shot Gas Cu. Ft.Dry Hole Abandoned

Date

MAY 17 1944 19S. J. LEWIS Scout

KANSAS

Pool Name Nunn Pool

Map No. N M Sec. 26 Twp. 21 R. 34W

Well No. 2 Davis

Atlantic Company

COMPLETED

Contractor

Q NW NW

SECTION PLAT

660 Ft. from N. Line

_____ Ft. from S. Line

_____ Ft. from E. Line

660 Ft. from W. Line

o			

Finney

Location _____

Rig up _____

Drilling and Remarks:

Misc 4610
5" @ 4614
9000 acid
Pump 4620 ft
2 7/8 W.
27 2/8

RECORD

Cased _____ in., _____ ft.

Sand _____

Gas _____

Oil _____

Total Depth 4675

PRODUCTION

1st 24 hrs. Nat. _____

1st 24 hrs. after shot _____

Gas _____ Cu. Ft.

Dry Hole _____

Abandoned _____

Date

AUG 16 1944

19

S. J. LEWIS

Scout