


Section 26 Township 21 Range 34WWell No. # 1, DavisCompany Atlantic

Nunn Pool

NORTH

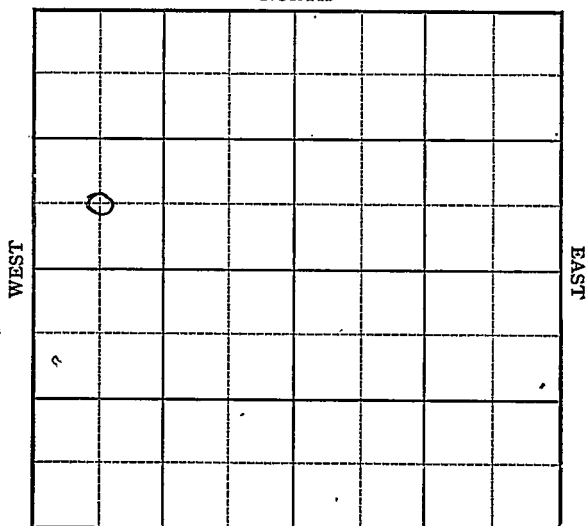

SOUTH

Sec. 26 Twp. 21 R. 34-WWell No. #1, Davis FarmAtlantic Company

S

Ft. from N. Line

660


Ft. from S. Line

Ft. from E. Line

660

Ft. from W. Line

Elev. 2948

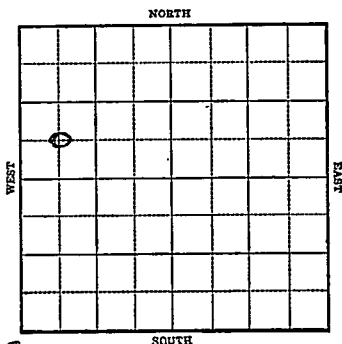

R E P O R T

1943	
12/15	Derrick
12-22	Drlg. 265'
12/29	Drlg 2470
	10" @ 246
1944	
1-5	Drlg 3350'
1-12	Drlg 4030'
1/19	Lans 3870
	Drlg. 4552'
1/26	Miss 4603
	SSO 4713' Drlg.
2/2	TD 4733 SSO
	5" @ 4605
	Rust
2/8	FSG
2/15	1500 acid
	Swb 8 oil per hr 10 hrs.
2/23	6000 acid
	Testing.

OVER

1944

3/1

5" @ 4605

Miss 4603

TD 4733

7500 acid

Pump 252 oil & 2.4% water

Gravity 30.4

COMPLETED

KANSAS
 Map No. 1717 Sec. 26 Twp. 21 R. 34W

Well No. 1 Davis

Atlantic Company

FIRST REPORT Contractor

C SW NW

SECTION PLAT

6			

 Ft. from N. Line

660 Ft. from S. Line

 Ft. from E. Line

660 Ft. from W. Line

Nunn Pool

Location

Rig up

Drilling and Remarks:

Derrick

RECORD

Cased in., ft.

Sand

Gas

Oil

Total Depth

PRODUCTION

1st 24 hrs. Nat.

1st 24 hrs. after shot

Gas Cu. Ft.

Dry Hole

Abandoned

Date

DEC 15 1943 19

S. J. LEWIS Scout

Map No. NM Sec. 26 Twp. 21 R. 34WWell No. 1 DavisAtlantic

Company

COMPLETED

Contractor

C SW NW

SECTION PLAT

6			

Ft. from N. Line

660

Ft. from S. Line

Ft. from E. Line

660

Ft. from W. Line

Nunn Pool

Location

Rig up

Drilling and Remarks:

*Min 4603**5' @ 4605**7500 acid**Prod 252 oil**2.4% water**35.4 hr*

RECORD

Cased _____ in., _____ ft.

Sand _____

Gas _____

Oil _____

Total Depth 4723

PRODUCTION

1st 24 hrs. Nat. _____

1st 24 hrs. after shot _____

Gas _____ Cu. Ft.

Dry Hole _____

Abandoned _____

Date

MAR 1 1944

19

S. J. LEWIS Scout