


Section 26 Township 21 Range 3/W

Well No. #3 Davis

Company Shallow Water Ref.

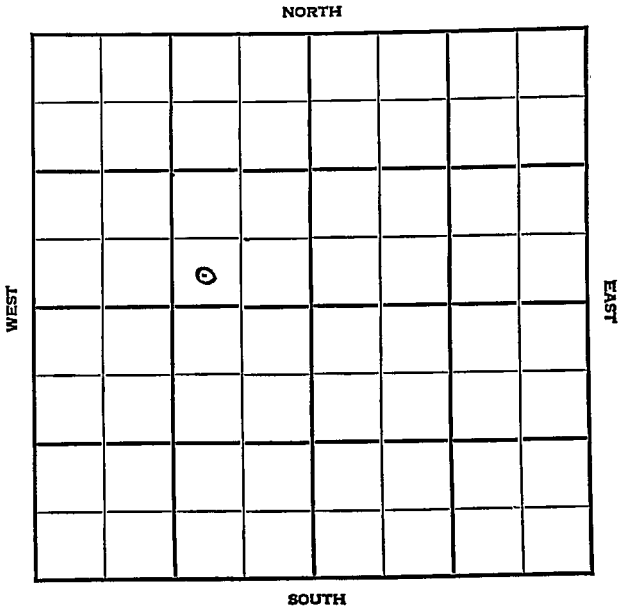



Sec. 26 Twp. 21 R. 34W

Well No. #3 Davis Farm

Shallow Water Ref. Company

Nunn


Ft. from N. Line

330' Ft. from S. Line

990' Ft. from E. Line

Ft. from W. Line

SW SE NW

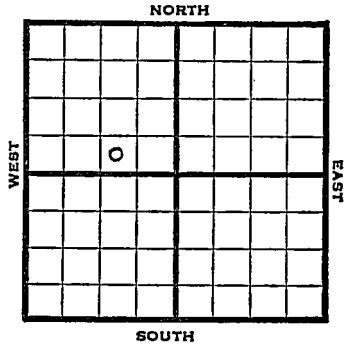

1948 Elev. 2940' REPORT

2/4 RUR

2/11 10" @ 266'  
Drlg. 3125'

2/18 Drlg 4046'

2/25 TD 4648'

3/3 Mississippi 4608'  
5" @ 4647'  
TD 4648'  
RUST

3/10 "

3/17 "

3/24 "

3/31 "

4/7 "

4/14 Drlg. 4670'

4/21 TD 4703'  
Estimate 150 bbls oil a day

4/28 "

5/5 Miss 4508'  
5" @ 4647'  
Perf 48 snots 4282-90  
9000 Acid  
Pump 286 Pot. oil  
Gr. 36  
TD 4703'

COMPLETED

Map No. \_\_\_\_\_ Sec. 26 Twp. 21 R. 34W

Well No. 3 Davis

Shallow Water Ref. \_\_\_\_\_ Company \_\_\_\_\_

FIRST REPORT

Contractor \_\_\_\_\_

SW SE NW

SECTION PLAT

\_\_\_\_\_ Ft. from N. Line

330 Ft. from S. Line

990 Ft. from E. Line

\_\_\_\_\_ Ft. from W. Line


Finney County

RECORD

Location \_\_\_\_\_

Cased \_\_\_\_\_ in., \_\_\_\_\_ ft.

Rig up \_\_\_\_\_

Sand \_\_\_\_\_

Drilling and Remarks:

Gas \_\_\_\_\_

R U R

Oil \_\_\_\_\_

Total Depth \_\_\_\_\_

PRODUCTION

1st 24 hrs. Nat. \_\_\_\_\_

1st 24 hrs. after shot \_\_\_\_\_

Gas \_\_\_\_\_ Cu. Ft.

Dry Hole \_\_\_\_\_

Abandoned \_\_\_\_\_

Date .

FEB 4 1948 19 \_\_\_\_\_

S. J. LEWIS Scout

Map No. \_\_\_\_\_ Sec. 26 Twp. 21 R. 34W

Well No. 3 Davis

Shallow Water Ref. \_\_\_\_\_ Company \_\_\_\_\_

**COMPLETE**

Contractor

SW SE NW

E. I. 2948

SECTION PLAT

\_\_\_\_\_ Ft. from N. Line

330 Ft. from S. Line

990 Ft. from E. Line

\_\_\_\_\_ Ft. from W. Line


Finney County

Location \_\_\_\_\_

Rig up \_\_\_\_\_

Drilling and Remarks:

*Wire 4608.*  
*5' @ 4647*  
*Ref 48 to 4252-90*  
*9000 acid*  
*Run 286 ft oil*  
*36 P.A.*

RECORD

Cased \_\_\_\_\_ in., \_\_\_\_\_ ft.

Sand \_\_\_\_\_

Gas \_\_\_\_\_

Oil \_\_\_\_\_

Total Depth 4709

PRODUCTION

1st 24 hrs. Nat. \_\_\_\_\_

1st 24 hrs. after shot \_\_\_\_\_

Gas \_\_\_\_\_ Cu. Ft.

Dry Hole \_\_\_\_\_

Abandoned \_\_\_\_\_

Date

MAY 5 1948 19

S. J. LEWIS Scout