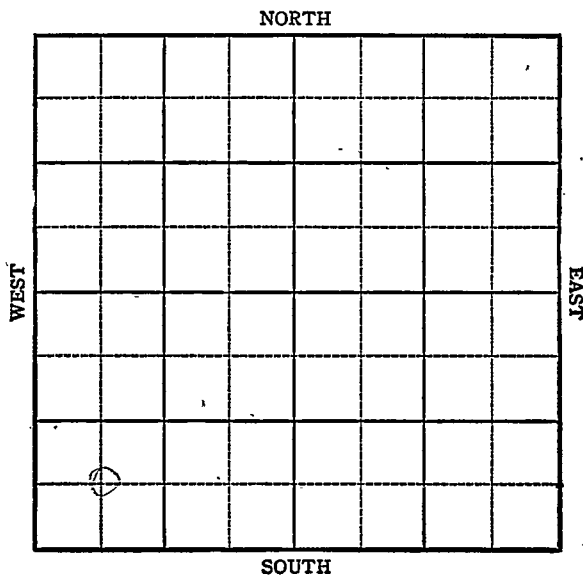


FORM 51 5M BRIX

Section 26 Township 21 Range 34WWell No. #3 MaunaCompany Black-Marshall

Finney County

Sec. 26 **KANSAS** Twp. 21 R. 34W

Well No. #3 Maune Farm


Black-Marshall Company
Shallow Water

 Ft. from N. Line

660 Ft. from S. Line

 Ft. from E. Line

660 Ft. from W. Line

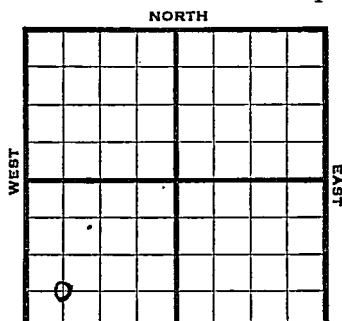

C SW SW Elev. 2944

1944

R E P O R T

12/13	Location
12/21	"
12/29	10" @ 254' Drlg. 3055'
<u>1945</u>	
1/3	Drlg 3869
1/10	Lans 3860
	Drlg 4265
1/17	Miss 4585 5" @ 4610
	TD 4615 Rust
1/26	" " " "
1/31	TD 4670' 1000' fluid
2/7	" " " "
2/14	Pump 2-3/4 fluid PH 6% water
2/21	Miss 4583
	5" @ 4610
	7000 acid
	TD 4670'
	Pump 626 oil plus 6% water Pot.
	Grav. 29.0

COMPLETED

Pool Name Shallow WaterMap No. 14M Sec. 26 Twp. 21 R. 34WWell No. 3 MaureBlack-Marshall

Company

FIRST REPORT

Contractor

C SW SW

SECTION PLAT

 Ft. from N. Line660 Ft. from S. Line Ft. from E. Line660 Ft. from W. LineFinneyLocation XRig up

Drilling and Remarks:

RECORD

Cased in., ft.Sand Gas Oil Total Depth

PRODUCTION

1st 24 hrs. Nat. 1st 24 hrs. after shot Gas Cu. Ft.Dry Hole Abandoned

Date

DEC 13 1944 19S. J. LEWIS

Scout

Pool Name Shallow-waterMap No. NM Sec. 26 Twp. 21 R. 34WWell No. 3 MauneBlack-Marshall CompanyCOMPLETED Contractor
C SW SW

SECTION FLAT

0			

 Ft. from N. Line660 Ft. from S. Line Ft. from E. Line660 Ft. from W. LineFinneyLocation Rig up

Drilling and Remarks:

Miss 4583
5-204610
7000 acid
Pump 626 oil + 6%
Water P.O.
29-2-4

RECORD

Cased in., ft.Sand Gas Oil Total Depth 4670

PRODUCTION

1st 24 hrs. Nat. 1st 24 hrs. after shot Gas Cu. Ft.Dry Hole Abandoned

Date

FEB 21 1945 19 S. I. LEWIS Scout