


Section 26 Township 21 Range 34W

Well No. 1 Edith Maune

Company Black-Marshall & S-P

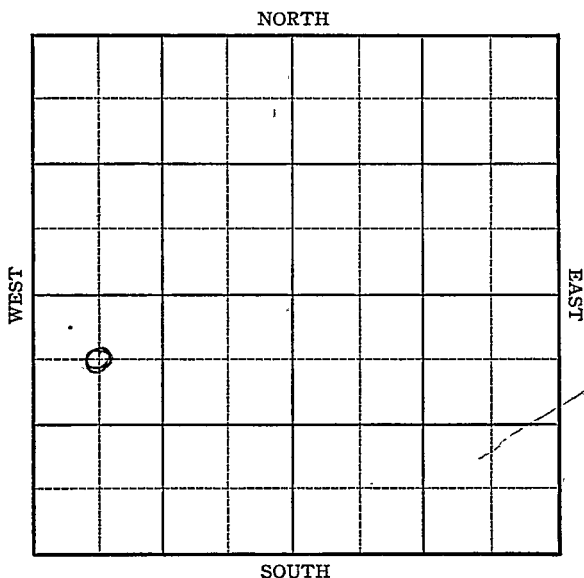

KANSAS

Finney

Sec. 26 Twp. 21 R. 34W

Well No. #1 Edith Manne Farm

Black-Marshall & SP Company


Wildcat

660 Ft. from N. Line

Ft. from S. Line

Ft. from E. Line

660 Ft. from W. Line

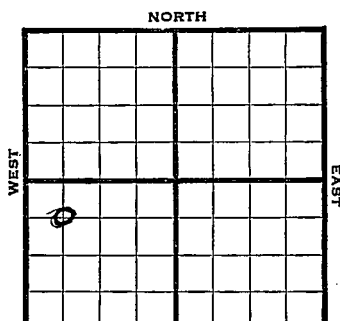

660 *2945*

C NW SW

1944

R E P O R T

8/30	Rotary
9/8	10" @ 245 Drlg. 1265
9/13	Drlg. 3310'
9/21	Topeka 3525
	Lans 3860
	Drlg. 4110
9/28	Miss 4590
	TD 4600 RUN 5"
10/4	" " " " "
10/11	Drlg. 4623
10/18	TD 4681 80' oil in 11 hrs. 8000 acid
10/25	" " " " " " "
11/1	Miss 4590
	5" @ 4600
	8000 acid
	Pump 560 Pot.
	TD 4687
	Grav. 37.

COMPLETED

Pool Name Will Goat

KANSAS


Map No. VM Sec. 26 Twp. 21 R. 34WWell No. 1 Edith MannoBlack-Marshall & S-P Company

FIRST REPORT

Contractor

C NW SW

SECTION PLAT

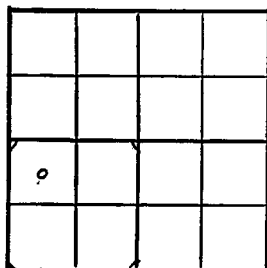660 Ft. from N. Line Ft. from S. Line Ft. from E. Line660 Ft. from W. LineFinneyLocation Rig up

Drilling and Remarks:

Rotary

RECORD

Cased in., ft.Sand Gas Oil Total Depth

PRODUCTION

1st 24 hrs. Nat. 1st 24 hrs. after shot Gas Cu. Ft.Dry Hole Abandoned

Date

AUG 3 0 1944 19

S. J. LEWIS


Scout

Pool Name NunnMap No. nm Sec. 26 Twp. 21 R. 34WWell No. 1 Edith MauneBlack-Marshall & S P Company**COMPLETED**

Contractor

C NW SW

SECTION PLAT

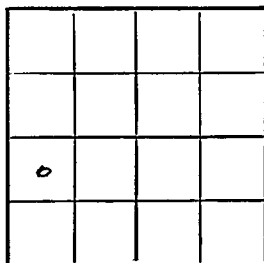660 Ft. from N. Line Ft. from S. Line Ft. from E. Line660 Ft. from W. LineFinneyLocation Rig up

Drilling and Remarks:

Miss 45905" @ 46008000 acd.Pump 560 Pst27-2-44

RECORD

Cased in. ft.Sand Gas Oil Total Depth 4677

PRODUCTION

1st 24 hrs. Nat. 1st 24 hrs. after shot Gas Cu. Ft.Dry Hole Abandoned

Date

NOV 1 1944 19S. J. LEWIS Scout