


Section 26 Township 21 Range 35 W

Well No. # 1 Hutchinson Gas Unit

Company Stanolind

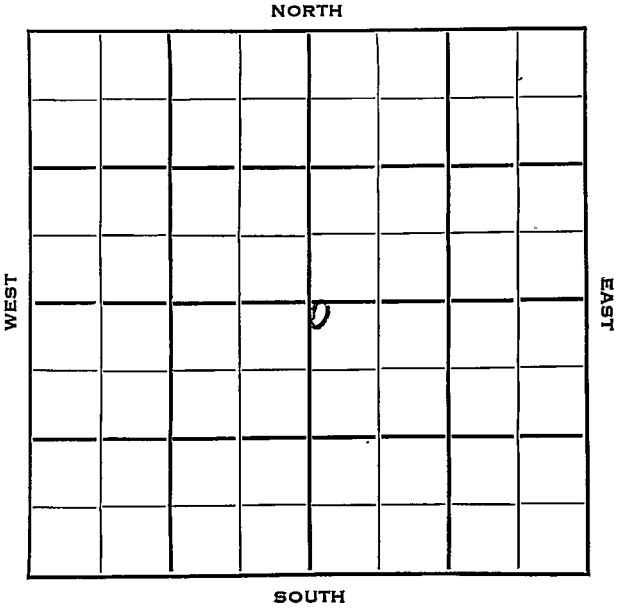

SEC. 26	TWP. 21	R. 35 W	✓
---------	---------	---------	---

WELL NO. # 1 Hutchinson Gas Unit FARM

COMPANY Stanolind

CONTRACTOR

Hugoton Pool


150 Ft. from N. Line

Ft. from S. Line

Ft. from E. Line

150 Ft. from W. Line

NW NW SE

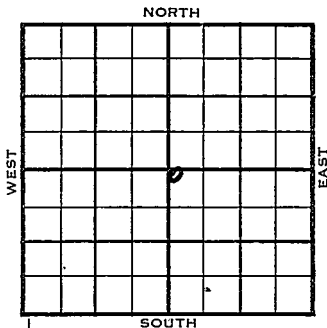

MCPC has SW of 35

	ELEVATION	REPORT
1953	3064'	
11/18	Spud 11-15-53 8" @ 810 WOC	
12/9	Her 2644', Kr 2670', Win 2710' RTD 2735' 5" @ 2710', WOC	
12/16	CO 2735 Frac S/250 gal SW Sq. 54/2648-57 42/2661-68 48/2670-78 Frac.	
1954 1/6	Spud 11-15-53 D & A TD 2735' 8" @ 810' Her. 2644', Kr. 2670', Win 2710', TD 2735' 5" @ 2710' CO to 2735 frac 2000 A S/ 250 gswph 54/ 2648-57 42/ 2661-68 48/ 2670-78 3000 A D & A	

ABANDONED

County Kearny State Kansas

Sec. 26 (Blk. 21 (Sur. 35W (Twp.) (Rge.) Map No.

Operator Stanolind

Well No. 1 Farm Hutchinson Gas Unit

Elev. 3064 Location NW NW SE

150 Ft. From N Line SE

150 Ft. From W Line Quarter

1st. Report

Completion JAN 6 1954

Remarks Hugoton Pool

Spudding Date 11-15-53

Drlg. Data D & A TD 2735

8" @ 810 Her. 2644 Kri. 2670

Win. 2710 TD 2735 5" @ 2710

CO to 2735 frac 2000 A S/ 250 gswph

54/ 2648-57 42/ 2661-68 48/ 2670-78

3000 A

D & A