


Section 27 Township 21 Range 12WWell No. #1, FreemanCompany B & R Drlg.

KANSAS

Stafford County

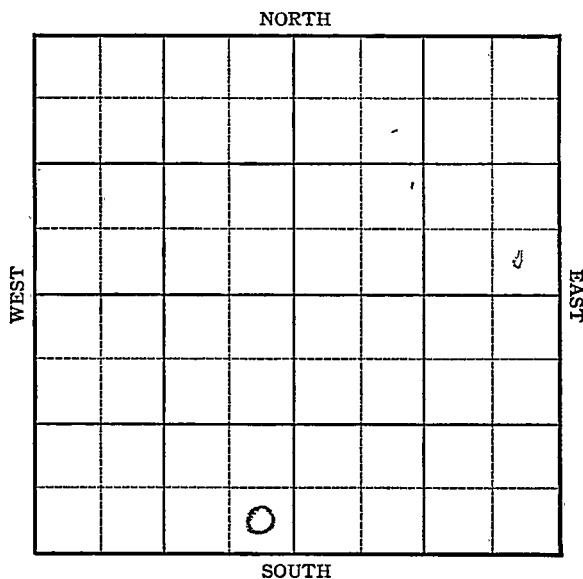

Sec. 27 Twp. 21 R. 12W

Well No. #1 Freeman Farm

B & R Drlg. Company

Sittner

 Ft. from N. Line

330


 Ft. from S. Line

330

 Ft. from E. Line

 Ft. from W. Line

SE SW

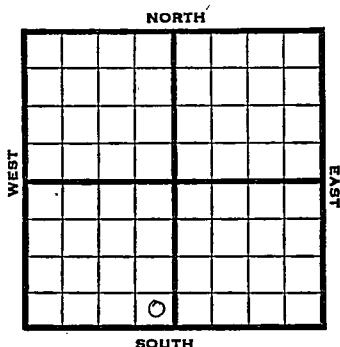

1946

Elev. 1854

REPORT

4/17 Location

4/23 "

5/1 "

5/7 8" @ 290'

Anhy 765

Drlg 1890'

5/14 Lans 3308 Drlg

5/22 Lans 3293

Cong 3570

3738' in Cong.

TD 3738'

ABANDONED


KANSASKansas Pool Name SittnerMap No. 46 Sec. 27 Twp. 21 R. 12WWell No. 1 FreemanB & R. Drlg.

Company

FIRST REPORT

Contractor

SE SW

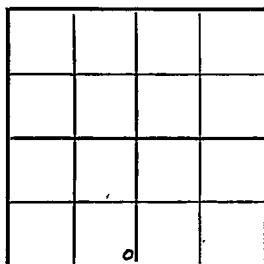SECTION PLAT

Ft. from N. Line

330

Ft. from S. Line

330

Ft. from E. Line

Ft. from W. Line

Stafford CountyLocation X

Rig up

Drilling and Remarks:

RECORDCased in., ft.Sand Gas Oil Total Depth **PRODUCTION**1st 24 hrs. Nat. 1st 24 hrs. after shot Gas Cu. Ft.Dry Hole Abandoned

Date

APR 17 1946 19S. J. LEWIS

Scout

KANSAS

Kansas Pool Name Sittner PoolMap No. 46 Sec. 27 Twp. 21 R. 12WWell No. 1 Freeman

B & R Drlg.

Company

ABANDONED

Contractor

SE SW

E 11/1854

SECTION PLAT

 Ft. from N. Line330 Ft. from S. Line330 Ft. from E. Line Ft. from W. LineStafford CountyLocation Rig up

Drilling and Remarks:

*Lans 3228**Cong 3570**275 in Cong***RECORD**Cased in., ft.Sand Gas Oil Total Depth 3228**PRODUCTION**1st 24 hrs. Nat. 1st 24 hrs. after shot Gas Cu. Ft.Dry Hole Abandoned

Date

MAY 22 1946 19S. J. LEWIS

Scout