

Section 27 Township 21 Range 12WWell No. #1 ShumwayCompany E. H. Adair

NORTH

WEST

0							

EAST

SOUTH

Stafford

27

21

12W

Sec. _____ Twp. _____ R. _____

Well No. #1 Shumway Farm _____

E. H. Adair Company _____

Contractor _____

Wildcat

330

Ft. from N. Line

Ft. from S. Line


Ft. from E. Line

330

Ft. from W. Line

NW NW NW

Sunray DHM

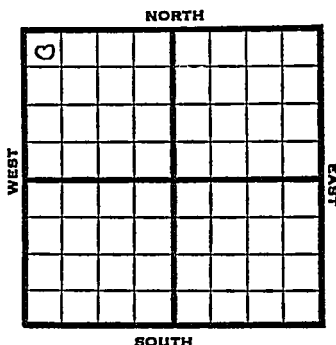

1952

Elev. 1845' REPORT

10/15

RUR

10/22

8" @ 337 Anhy 655'
Drlg. 2668'

10/29

Topeka 2823, Heeb 3120, Douglas 3152,
Br li 3253, Lans 3267
DST 3378-3402, 1 hr., 30' OCM, V 3501
Simp 3520
DST 3503-23 1/2 hr., 15' m
Arb 3571
TD 3573
5" @ 3572 1/2

11/5

CO 3573, FU 2000' oil 12 hrs.
S/4 BOPH to DD

11/12

DD 3570' TD S/10 BOPH 2 hrs. 500 A
S/120 BOPH 1 hr. 1700' off btm.

11/20

NR

11/26

Spud 10-14-52
Oil Well
TD 3570'
8" @ 337
Anhy 655', Top. 2823', Heeb
3120', Doug. 3152', Br Lime
3253', Lans 3267
DST 3378-3402, opn 1 hr.,
rec. 30' ocm 0#
Viola 3501, Simp 3520
DST 3503-23, opn 1/2 hr., rec.

OVER

1952 (Information Brought Forward)

II/26 15' mud, tr. free oil

Arb. 3 571

TD 3567'

5" @ 3572

CO to 3 567

FU 2000' oil 12 hrs., S/4 boph

DD 3570, S/10 boph 2 hrs., 500A

S/120 boph

Comp. 2121 bopd 21% WTR.

COMPLETED

County Stafford State KansasSec. 27 (Blk. Twp.) 21 (Sur. Rge.) 12W Map No.Operator E. H. AdairWell No. 1 Farm ShumwayElev. Location NW NW NW

0							

FIRST REPORT

330 Ft. From N Line NW330 Ft. From W Line Quarter1st. Report OCT 15 1952

Completion

Remarks Sunray - IHM


Spudding Date

Drlg. Data WildcatRUR

Scout Cards *W*
Land Small Map.....
Land Wall Map..... *5*
Tracings.....
France Map.....
Pierce Map.....
Misc.....

907 20 1952

Orig. Date

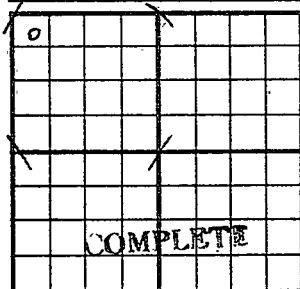County Stafford State KansasSec. 27 (Blk. Twp.) 21 (Sur. Rge.) 12W Map No. _____Operator E. H. AdairWell No. 1 Farm ShumwayElev. 1845 Location NW NW NW330 Ft. From N Line NW330 Ft. From W Line Quarter

1st. Report _____

Completion NOV 26 1952Remarks WildcatSpudding Date 10-14-52Drlg. Data Oil well TD 35708" @ 337- Anhy 655 Top. 2823Heeb. 3120 Doug. 3152 Br. lime 3253Lans. 3267 DST 3378-3402 open 1 hr.Rec. 30' ocm 0# Viola 3501Simpl 3520 DST 3503-23. open $\frac{1}{2}$ hr.Rec. 15' mud tr. free oil Arb. 3571TD 3563 5" @ 3572 CO. to 3563FU 2000' oil 12 hr. S/ 4 boph DD 3570S/ 10 boph 2 hr. 500 A S/ 120 bophComp. 2121 bopd 21% wtr.

J. G. McGEHEE

Scout Cards

Land Small Map.....

Land Wall Map.....

Tracings

France Map

Pierce Map.....

Misc.

DEC 4 1952

Orig. Date