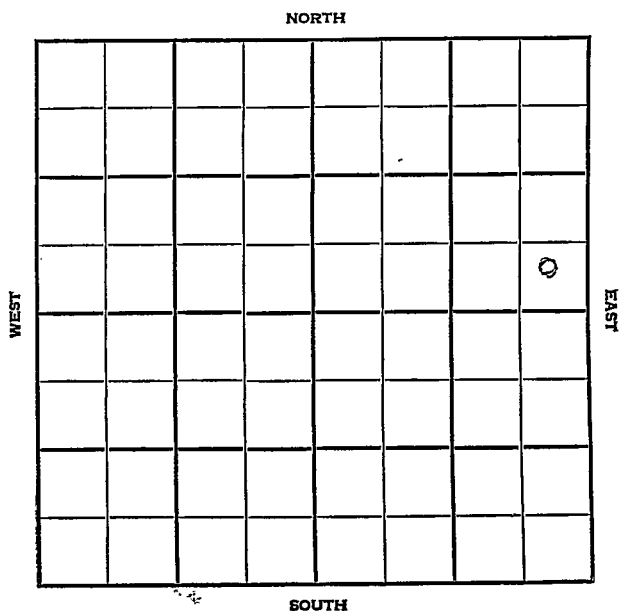


Section 27 Township 21 Range 12 WWell No. #1 WilsonCompany Dike Drlg.

Stafford

KANSAS

SEC.	TWP.	R.
27	21	12W

WELL NO.

#1-Wilson

FARM

COMPANY

Duke Drlg.

CONTRACTOR

Co. Tools

N. Max


Ft. from N. Line

Ft. from S. Line

Ft. from E. Line

Ft. from W. Line

SE SE NE

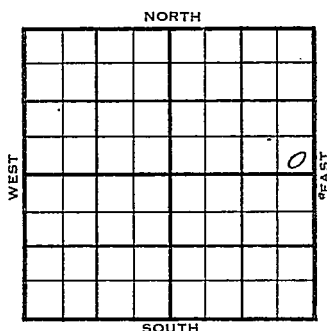

1956

ELEVATION

1837

REPORT

3-14

Comm. 3-6-56

8" @ 256/150

Drlg. 2855

Anh. 621

3-21

D & A

H. 3124

BL 3257

L. 3277

C. Cherty 3545

TD 3640'


ABANDONED

County Stafford Elev. 1837
 Sec. 27 Twp. 21 Rge. 12W
 Company Duke Drilg.
 Farm Name Wilson No. 1

TOPS	DEPTH	LOG	DATUM	Loc. in Sec.
Anh.	621			SE SE NE
Tr.				
H.				
Tr.				
Dg.				
Bl.				
L.				
K.C.				Geol.
B.K.C.				Contr.
Ce.				Co. tools
C.				Pool
M.				N. Max
M.				
K.				
Mz.				
Me.				
V.				
S.				
S.				
A.				
R.				
Pe.				
G.				
T.D.				

Date Comm. 3-6-56
8" @ 256/150 drlg. 2855

MAR 14 1956

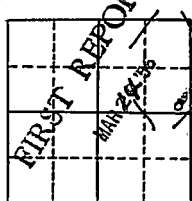

County Stafford Elev. 1837
 Sec. 27 Twp. 21 Rge. 12W
 Company Duke Drilg.
 FarmName Wilson No. 1

TOPS	DEPTH	LOG	DATUM	Loc. in Sec.
Anh.	621			SE SE NE
Tr.				
H.	3124			
Tr.				
Dg.				
BL.	3257			
L.	3277		1440	Geol.
K.C.				Contr.
B.K.C.				
Ce.				
C. <i>Chesty</i>	3545		1708	Co. tools
M.				
M.				Pool
K.				N. Max
Mz.				
Me.				
V.				
S.				
S.				
A.				
R.				
Pe.				
G.				
TD.	3640			

Date Comm. 3-6-56 MAR 21 1956

8" @ 256/150

D & A

ABANDONED