

Stafford


DX 78-1

KANSAS

Section 27 Township 21 Range 12W

Well No. #1 Wilson "E"

Company Petroleum Inc.

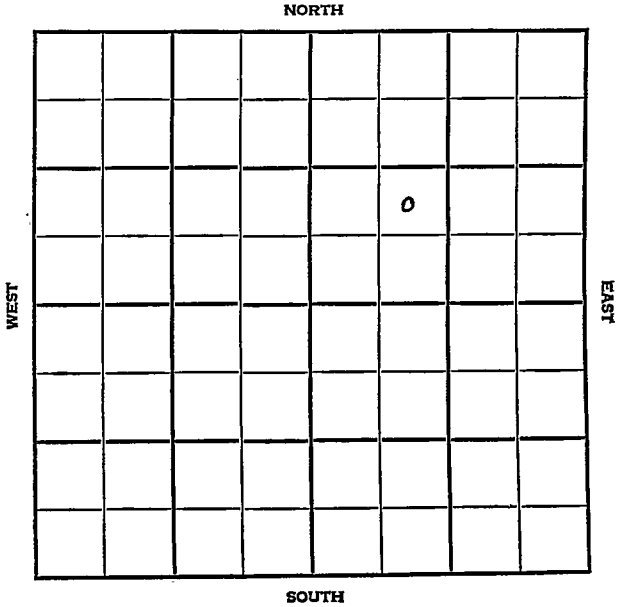

Stafford

KANSAS

SEC. 27	TWP. 21	R. 12W
------------	------------	-----------


WELL NO. #1 Wilson "E" FARM

COMPANY Petroleum Inc.

CONTRACTOR Garvey Tools Rig #3.

Syms SE Ext.

_____ Ft. from N. Line
 990 _____ Ft. from S. Line
 _____ Ft. from E. Line
 990 _____ Ft. from W. Line

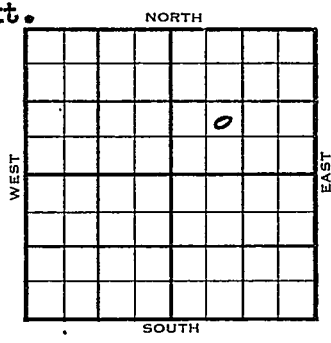

NE SW NE

	ELEVATION	REPORT
--	-----------	--------

1954 1844' DF

9/22 Spud 9-17-54
 8" @ 220'
 Drlg. 2082'

9/29 Spud 9-17-54
 D&A
 TD 3655'
 8" @ 220'
 Heeb 3118', Br. line 3250', L ans
 3263', Viola 3522', Simp. 3552', Arb.
 3603'
 DST 3607-16', opn 1 hr., rec. 20' OCM,
 Off
 DST 3611-25', opn 1 hr., rec. 30' OCM,
 Off
 DST 3625-45', opn 1 hr., rec. 45' OCM,
 330#
 DST 3643-55', opn 1/2 hrs., rec. 80' mud
 Off
 TD 3655'
 D&A

ABANDONED

