


Section 27 Township 21 Range 12W

Well No. #3 Shumway

Company E. H. Adair & Lee Phillips

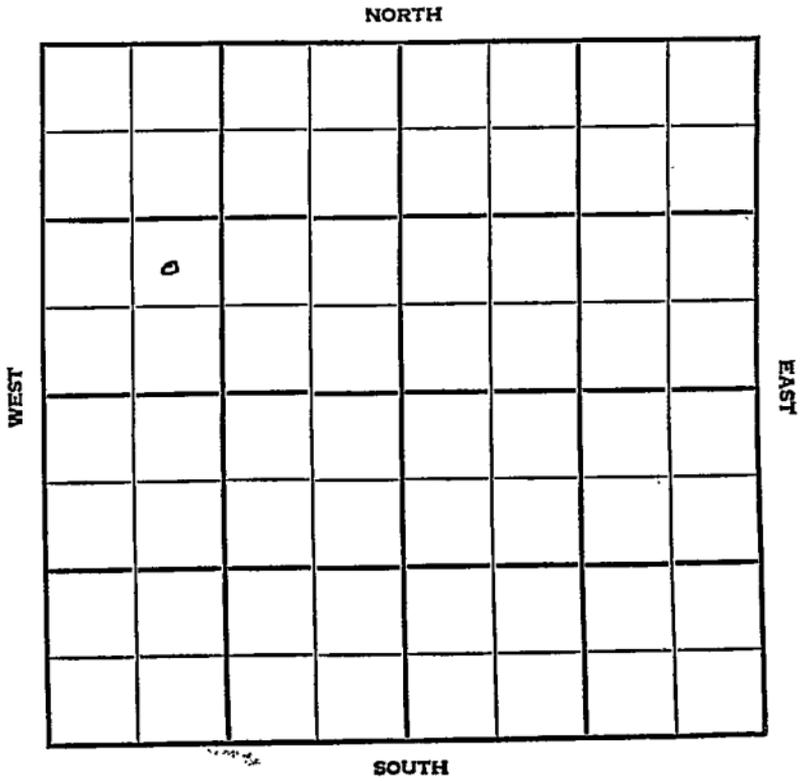

Stafford KANSAS


| | | |
|------|------|-----|
| SEC. | TWP. | R. |
| 27 | 21 | 12W |

WELL NO. 3 Shumway FARM

COMPANY E. H. Adair & Lee Phillips

CONTRACTOR Adair
Sitrner Pool

_____ Ft. from N. Line
990 _____ Ft. from S. Line
_____ Ft. from E. Line
990 _____ Ft. from W. Line

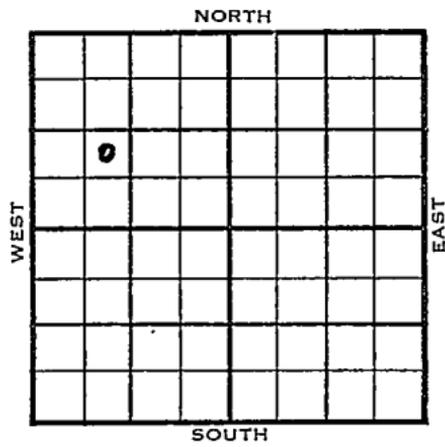

NE SW NW

| | ELEVATION | REPORT |
|------|-----------|--------|
| 1955 | 1857' | |

4/13 2' pud 4-5-55
8" @ 322'
rlg. 3259'

4/27 3' pud 4-5-55 - D&A
TD 3612'
8" @ 322'
Heeb. 3125', Br lime 3259', L ans. 3273
Arb. 3599'
TD 3606'
5" @ 3600'
DD 3608'
DD 3612'
D&A

ABANDONED

County Stafford State Kansas

Sec. 27 (Blk. Twp.) 21 (Sur. Rge.) 12W Map No.

Operator E. H. Adair & Lee Phillips

Well No. 3 Farm Shumway

Elev. 1857 Location NE SW NW

| | | | | | |
|--|--|--|--|--|--|
| | | | | | |
| | | | | | |
990 Ft. From S Line NW

990 Ft. From W Line Quarter

1st. Report

Completion APR 27 1955

Remarks Sitner Pool

Adair - Contr.

Spudding Date 4-5-55

Drig. Data D & A TD 3612

8" @ 322 Heeb. 3125 Br. lime 3259

Lans. 3273 Arb. 3599 TD 3606

5" @ 3600 DD 3608 DD 3612

D & A

FABEN GILSTRAP