

Clafford

Form 51-5M-11-31-Palace

Map No. KANSAS Sec


Twp.

R.

Well No.

Farm

Company

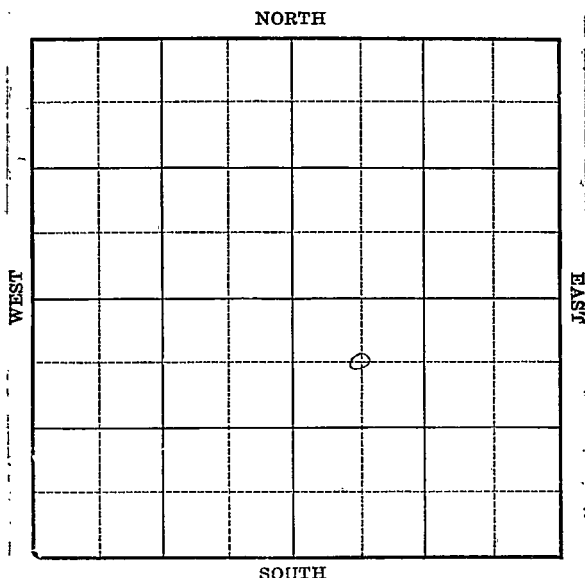

Location

Drilling Remarks

Rig Up

Drilling Remarks

RECORD

Cased in. ft.

Sand

Gas

Oil

Total Depth

PRODUCTION

1st 24 hrs. Nat.

1st 24 hrs. after shot

Gas cu. ft.

Dry Hole

Abandoned

Stafford
Form 252-A
5M 4-32 MPC

Map No. KANSAS Sec. 27 Twp 21 R. 13^w
Well No. 1-Gates Farm
Atlantic Oil Prod Company


660 Ft. from N. Line

_____ Ft. from S. Line

_____ Ft. from E. Line

660 Ft. from W. Line

1933

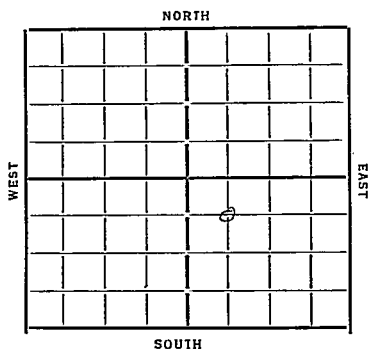

Date

REPORT

1/18	Loc
1/25	Bldg rig
2/11	Ran up
2/8	C
2/15	Drilling 20"-65'
2/22	24"-84'
	20"-162'
	Drly 22.5'
3/4	15" 474 dly 550
3/8	Drly 1250'
3/12	15" - 740' 12 1/2 1325 Drly 1730'
3/22	
3/29	16" 2220' TD. 2585 U.R. 10"
4/4	10" 2575 Drly 2840
4/12	X TD 3048-60' 8" 3060' TD. 3110 U.R. 8"
4/19	3169 U.R. 8"
4/26	8" 3326 - Top K.G. 3339' fighting Cave 3349'
5/4	set 6" 3575 C.O.
5/10	Top Selecur line 3679 TD. 3742 2000' set 11 hrs (Telegram) No water gravity 39.9 well swab

1933

5/17 swab 176 bbls 18 $\frac{3}{4}$ hr swabbed
to 450' off bottom S. 70.

5/24 - Sand 3679-3704
swab 150 bbls
24 hours
(Completed)

82

KANSAS

Map No.

Sec.

27

Twp.

21

R. 13

W

Well No.

1

Gates

Atlantic Oil & Prod Co

Company

Contractor

FIRST REPORTS

SECTION PLAT

660 Ft. from N. Line

Ft. from S. Line

Ft. from E. Line

660 Ft. from W. Line

Location ✓

Rig up

Drilling and Remarks:

RECORD

Cased in, ft.

Sand

Gas

Oil

Total Depth

PRODUCTION

1st 24 hrs. Nat.

1st 24 hrs. after shot

Gas Cu. Ft.

Dry Hole

Abandoned

Date

JAN 1 8 1933

192

CHAS. L. SHERWOOD

Scout

W. J. C.
W. J. C.
W. J. C.

Returned	<i>[Signature]</i>
Cards	<i>[Signature]</i>
Tracing	<i>[Signature]</i>
France Map	<i>[X]</i>
Scarborough Map	<i>[X]</i>
Moody Map	<i>[X]</i>
Scarborough Flat Es.	<i>[X]</i>
Moody Flat Es.	<i>[X]</i>

82 **KANSAS** *Shapiro*
 Map No. _____ Sec. *27* Twp. *21* R. *13*^w

Well No. *1* *Gates*

Atlantic Oil & Prod Company

Contractor

COMPLETED

SECTION PLAT

660 Ft. from N. Line

_____ Ft. from S. Line

_____ Ft. from E. Line

660 Ft. from W. Line

Location _____

Rig up _____

Drilling and Remarks:

Drab 150 Bbls
24 hours

RECORD

Cased _____ in., _____ ft.

Sand *Silt* *367 9-3704*

Gas _____

Oil _____

Total Depth *3704*

PRODUCTION

1st 24 hrs. Nat. _____

1st 24 hrs. after shot _____

Gas _____ Cu. Ft.

Dry Hole _____


Abandoned _____

Date

MAY 24 1933

CHAS. L. SHERWOOD

192 _____ Scout

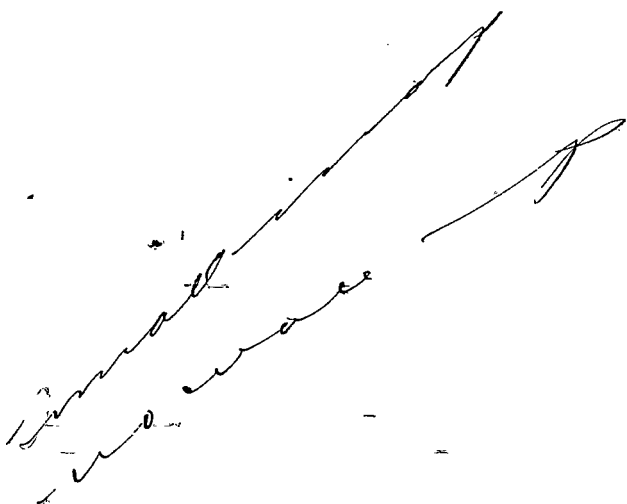

Returned	
Cards	<i>[Signature]</i>
Tracing	<i>[Signature]</i>
France Map	<i>[X]</i>
Scarborough Map	<i>[X]</i>
Moody Map	<i>[X]</i>
Scarborough Plat Book	
Moody Plat Book	