

Section 27 Township 21 Range 13W

Well No. 1 Scharz

Company Lion Oil

Gates Pool
NORTH

NORTH

WEST

EAST

SOUTH

Sec. 27 Twp. 21 R. 13-W ✓

Well No. #1 Schartz Farm

Lion Oil Company
Gates Pool


 Ft. from N. Line

330 Ft. from S. Line

 Ft. from E. Line

990 Ft. from W. Line

SE SW NW

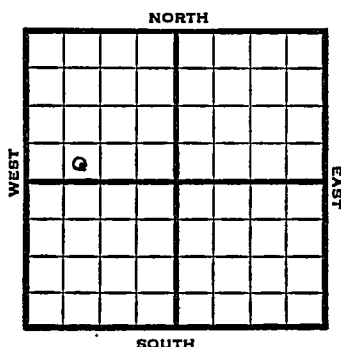

1948 Elev. 1884' REPORT

11/3 8" @ 259

Drlg 2110'

11/10 Lansing 3329'

Viola 3602'

Simpson 3649'

Arb 3689'-95'

TD 3695'

5" @ 3690'

11/16 TD 3722 - 2000 acid

1 bbls fluid PH, 70% W

11/23 "

11/30 "

12/6 "

12/14 "

12/22 Arb 3689'

5" @ 3690'

Pump 105 oil Pot. & 2 1/2% W

Gr. 390

TD 3722'

COMPLETED

Map No. _____ Sec. 27 Twp. 21 R. 13W

Well No. 1 Scharitz

Lion Oil


Company

FIRST REPORT

Contractor

SE SW NW

SECTION PLAT

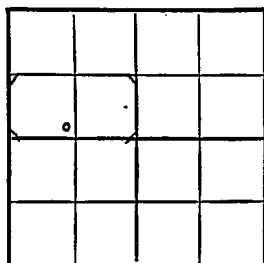

_____ Ft. from N. Line

330 Ft. from S. Line

_____ Ft. from E. Line

990 Ft. from W. Line

Stafford County

RECORD

Location _____

Cased _____ in., _____ ft.

Rig up _____

Sand _____

Drilling and Remarks:

Gas _____

8" @ 259

Oil _____

drlg. 2110

Total Depth _____

PRODUCTION

1st 24 hrs. Nat. _____

1st 24 hrs. after shot _____

Gas _____ Cu Ft.

Dry Hole _____

Abandoned _____

Date

NOV 3 1948 19

S. J. LEWIS Scout

Map No. 82 Sec. 27 Twp. 21 R. 13WWell No. 1 SchartzLion Oil

Company

COMPLETE

Contractor


SE SW NW

E. 1. 1884
SECTION PLAT Ft. from N. Line330

Ft. from S. Line

 Ft. from E. Line990

Ft. from W. Line

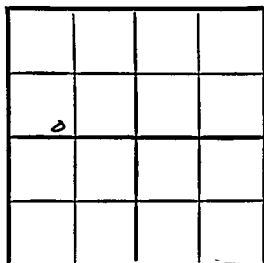

Stafford County

RECORD

Location Cased in., ft.Rig up Sand

Drilling and Remarks:

Gas Oil ✓ Total Depth 3222

PRODUCTION

1st 24 hrs. Nat. 1st 24 hrs. after shot Gas Cu. Ft.Dry Hole Abandoned

Date

DEC 22 1948

19

S. J. LEWIS

Scout