

# KANSAS


FORM 51 5M 1-42 PETROL

Stafford

Section 27 Township 21 Range 13W

Well No. 1 Schwartz

Company Phillips

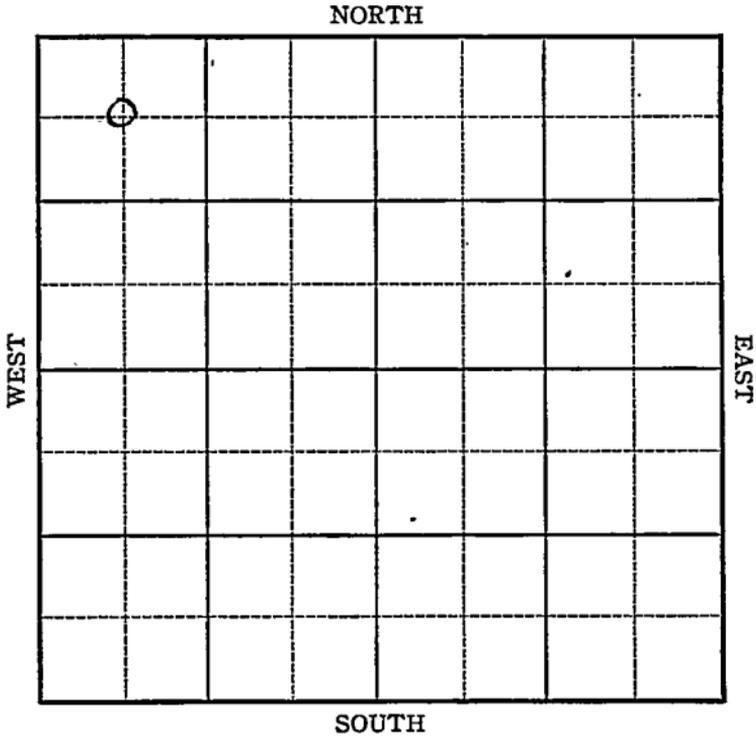

KANSAS


Stafford

Sec. 27 Twp. 21 R. 13-W

Well No. #1 Schwartz Farm

Phillips Company

NORTH

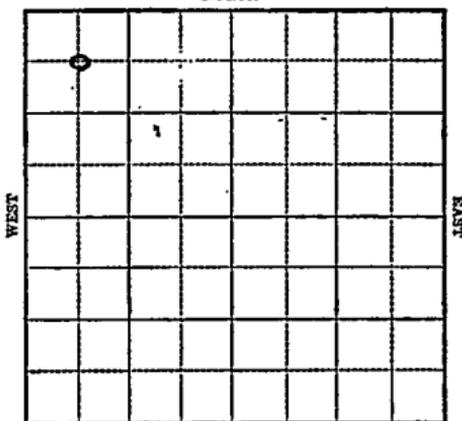

SOUTH

660 Ft. from N. Line

\_\_\_\_\_ Ft. from S. Line

\_\_\_\_\_ Ft. from E. Line

660 Ft. from W. Line

1943

*E1. 1884* R E P O R T

11/17 Location.  
11/24 "  
12/1 8" @ 392  
Drlg 1608'  
12/8 Drlg 3234  
12/15 Viola 3641  
Arb 3721  
T.D. 3750

ABANDONED

KANSAS

Map No. 82 Sec. 27 Twp. 21 R. 13WWell No. 1 SchwartzPhillips

Company

FIRST REPORT

Contractor

C NW NW

## SECTION PLAT

660

Ft. from N. Line

Ft. from S. Line

Ft. from E. Line

660

Ft. from W. Line

o			

Gates Pool

Location X

Rig up \_\_\_\_\_

Drilling and Remarks:

## RECORD

Cased \_\_\_\_\_ in., \_\_\_\_\_ ft.

Sand \_\_\_\_\_

Gas \_\_\_\_\_

Oil \_\_\_\_\_

Total Depth \_\_\_\_\_

## PRODUCTION

1st 24 hrs. Nat. \_\_\_\_\_

1st 24 hrs. after shot \_\_\_\_\_

Gas \_\_\_\_\_ Cu. Ft.

Dry Hole \_\_\_\_\_

Abandoned \_\_\_\_\_

Date

NOV 17 1943 19S. J. LEWIS

Scout

KANSAS

Map No. 82 Sec. 27 Twp. 21 R. 13WWell No. 1 SchwartzPhillips CompanyABANDONED Contractor

C NW NW

## SECTION PLAT

660 Ft. from N. Line

0			

         Ft. from S. Line         Ft. from E. Line660 Ft. from W. LineGates PoolLocation         

## RECORD

Cased          in.,          ft.Sand         Gas         Oil         Total Depth 8750Rig up         

Drilling and Remarks:


## PRODUCTION

1st 24 hrs. Nat.         1st 24 hrs. after shot         Gas          Cu. Ft.Dry Hole         Abandoned         

Date

DEC 15 1943 19S. J. LEWIS Scout