


Section 27 Township 21 Range 13-W

Well No. #1 Schartz

Company Todd Drlg. etal

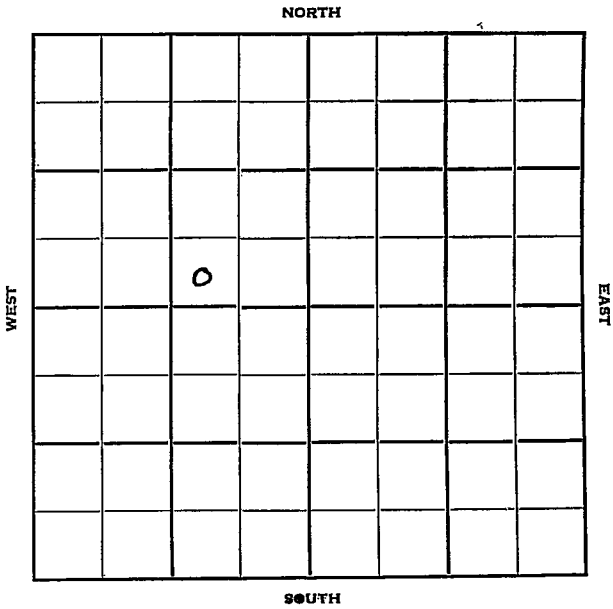

Sec. 27 Twp. 21 R. 13W

Well No. #1 Schartz Farm

Todd Drlg. et al. Company

Todd Drlg. - Contr. Contractor

Gates Pool


 Ft. from N. Line

300' Ft. from S. Line

990' Ft. from E. Line

 Ft. from W. Line

SW SE NW Twin

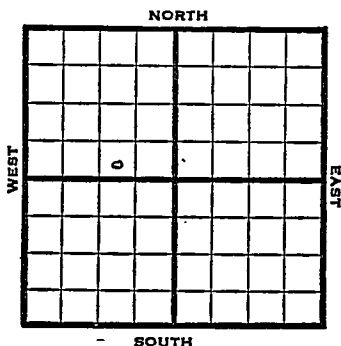

1950 Elev. 1886' REPORT

11/15 8" @ 248'
Drlg. 1780'

12/6 Oil Well TD 3751
8" @ 248' Heeb. 3197'
Br Lime 3328' Lans. 3339
DST 3379 -3436 opn 1 hr
Rec. 125' mud & oil 125' oil
Viola 3602 Simp. 3664
Arb. 3724'
5" @ 3724 TD 3751
SP 3581 3/3531-34 30/3521-29
SSO 14/3506-10 2000 A SO 4000 A
no inc. SP 3480 6/3426-32
24/3425-31 1000 A SP 3418
28/3410-16 14/3381-94
20/3376-81 1000 A S/31 boph
Comp. 100 Bopd

COMPLETED

