


O.W.W.O.

KANSAS Stafford

Section 27 Township 21 Range 13WWell No. 4 GatesCompany Lion Oil

Gates Pool

NORTH

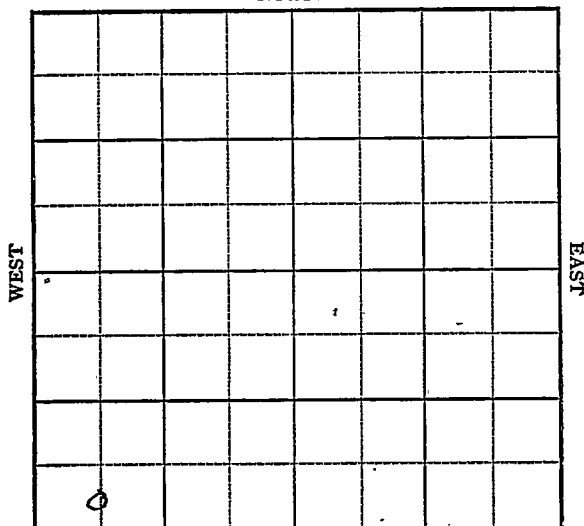

SOUTH

KANSAS Stafford

Sec. 27 Twp. 21 R. 13-W

Well No. #4 Gates Farm

Lion Oil Company
Gates Pool


 Ft. from N. Line

330 Ft. from S. Line

 Ft. from E. Line

660 Ft. from W. Line

C S L SW SW

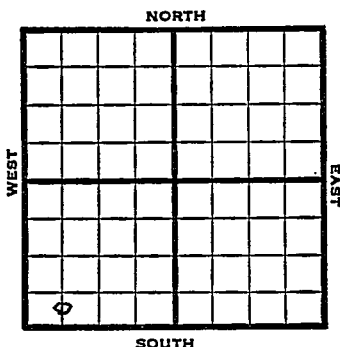

1948 Eli 1891' REPORT

11/3 8" @ 256

11/10 Drlg 1000
Lansing 3360'
Viols 3635'
Simpson 3658'
Arb. 3698'
TD 3701'
5" @ 3698'

11/16 TD 3704'

11/23 1000 acid
"

12/ 1 TD 3704'
Arb. 3698'
5" @ 3698'
1000 acid
Pump 100 Oil Pot
40° Gr.
Comp

COMPLETED

1951

6/6 Oil Well TD 3666'
5" @ 3698 Viola 3635
Simp sh 3658 Simp dol. 3674
Arb. 3698-3704 OTD 3704
PB 3666 47/3635-51 Comp. 60 BOPD

O.W.W.O.

FIRST REPORT

COMPLETE

Map No. _____ Sec. 27 Twp. 21 R. 13W

Well No. 4 Gates

Lion Oil Company

FIRST REPORT Contractor

C S L SW SW


SECTION PLAT

_____ Ft. from N. Line

330 Ft. from S. Line

_____ Ft. from E. Line

660 Ft. from W. Line

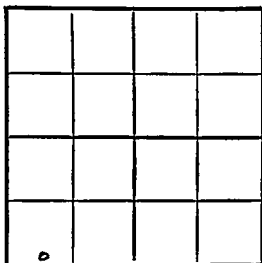

Stafford County

Location _____

Rig up _____

Drilling and Remarks:

8" @ 256

drlg. 1000

RECORD

Cased _____ in., _____ ft.

Sand _____

Gas _____

Oil _____

Total Depth _____

PRODUCTION

1st 24 hrs. Nat. _____

1st 24 hrs. after shot _____

Gas _____ Cu. Ft.

Dry Hole _____

Abandoned _____

Date

NOV 3 1948 19

S. J. LEWIS

Scout

Map No. 82 Sec. 27 Twp. 21 R. 13W

Well No. 4 Gates

Lion Oil


Company

COMPLETE

Contractor

C S L SW SW

E 11991
SECTION PLAT

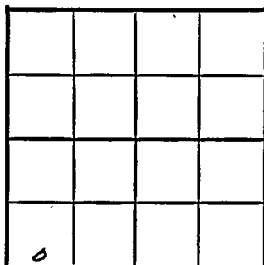

Ft. from N. Line

330

Ft. from S. Line

Ft. from E. Line

660

Ft. from W. Line

Stafford County

Location

Rig up

Drilling and Remarks:

Per 3698
5" @ 3698
1500000
Pump 100 oil 100

40° S

RECORD

Cased in., ft.

Sand

Gas

Oil

Total Depth 2254

PRODUCTION

1st 24 hrs. Nat.

1st 24 hrs. after shot

Gas Cu. Ft.

Dry Hole

Abandoned

Date

DEC 1 1948 19

S. J. LEWIS

Scout

Sec. **27** (Blk.) **21** (Sur.) **13W** Map No.

Well No. 4 Farm Gates

Elev.	1891	Location	C S L SW SW
-------	------	----------	-------------

0

FIRST REPORT
COMPLETED

330 Ft. From S Line SW

660 Ft. From W Line Quarter

1st. Report **JUN 6 1951**

Completion JUN 6 1951

Remarks (ONE TWO)

Spudding Date

Drlog. Data Oil well TD 3666 Gates Pool

5" @ 3698 Viola 3635 Simp. sh. 3658

Simp. dol. 3674 Arb. 3698-3704 OTD 3704

PB 3666 47/ 3635-51 Comp. 60 bopd

J. E. TYRA