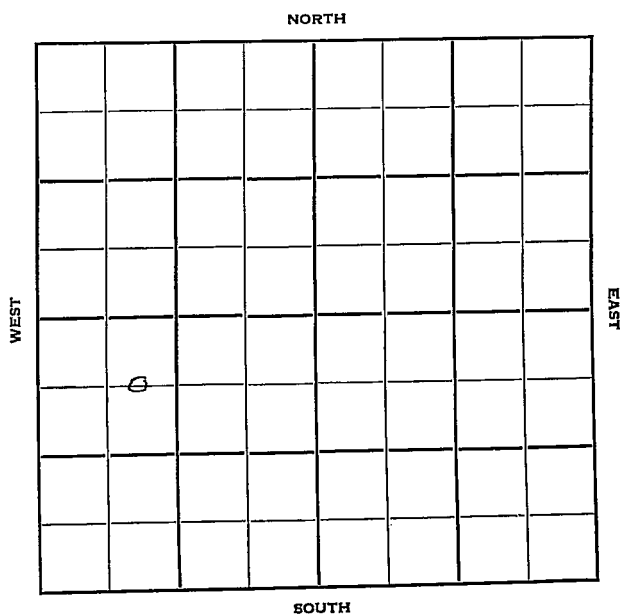


Section 27 Township 21 Range 13WWell No. #7 SitesCompany Lion Oil

Stafford

KANSAS

Sec. 27 Twp. 21 R. 13 W 1

Well No. # 7 Sites Farm

Lion Oil Company

Gates Pool


660 Ft. from N. Line

 Ft. from S. Line

 Ft. from E. Line

990 Ft. from W. Line

C E L NW SW

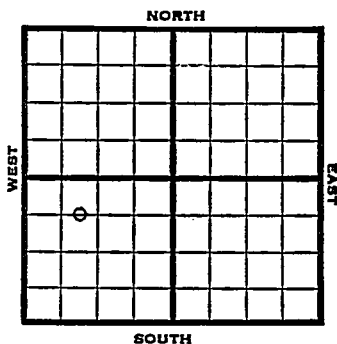

1951 Elev. 1885' REPORT

8/22
10/17

Location

Spud 9-3-51

Oil well TD 3683'

9" @ 260'

Heeb. 3184 Br. Lime 3313

Lans. 3325 Viola 3580

Simp. 3627 Arb. 3681-83

5" @ 3682 118/ 3580-3616

SSO & Gas 1000A B/ 5 gfph

SP 3560 18/ 3534-40

24/ 3510-18 66/ 3482/3504

27/ 3468-77 wtr. SP 3464


33/ 3450-61 27/ 3410-19

35/ 3394-3406 SO & Gas

1000 A F/ 3 MCFG & 3 BOPH


Comp. 2 $\frac{1}{2}$ MCFGPD 50 BOPD

COMPLETED

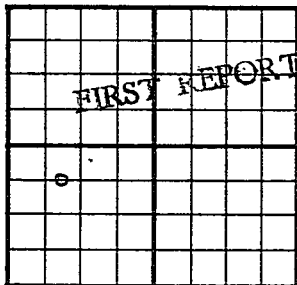County Stafford State KansasSec. 27 (Blk. Twp.) 21 (Sur. Rge.) 13W Map No.Operator Lion OilWell No. 7 Farm SitesElev. Location C E L NW SW660 Ft. From N Line SW990 Ft. From W Line Quarter1st. Report AUG 22 1951CompletionRemarksSpudding DateDrlg. Data Gates PoolLocation

J. E. TYRA

County Stafford State Kansas
 Sec. 27 (Blk. Twp.) 21 (Sur. Rge.) 13W Map No. _____
 Operator Lion Oil
 Well No. 7 Farm Sites
 Elev. 1885 Location C E L NW SW

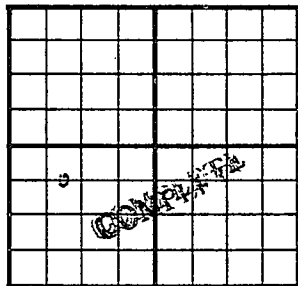

660 Ft. From N Line SW
990 Ft. From W Line Quarter
 1st. Report _____
 Completion OCT 17 1951
 Remarks Gates Pool

Spudding Date 9-3-51

Drlg. Data Oil well TD 3683

9" @ 260 Heeb. 3184- Br. lime 3313

Lans. 3325 Viola 3580 Simp. 3627

Arb. 3681-83 5" @ 3682 118/ 3580-3616

SSO & gas 1000 A B/ 5 gfph SP 3560

18/ 3534-40 24/ 3510-18 66/ 3482-3504

27/ 3468-77 water SP 3464 33/ 3450-61

27/ 3410-19 35/ 3394-3406 SO & gas

1000 A F/ 3 mcfg & 3 boph

Comp. 2 $\frac{1}{2}$ mcfgpd 50 bopd

J. E. TYRA