

Stafford


KANSAS

FORM 51 5M 2-38 TPCO.

Section 27 Township 21 Range 13-W

Well No. 8 Gates

Company Atlantic

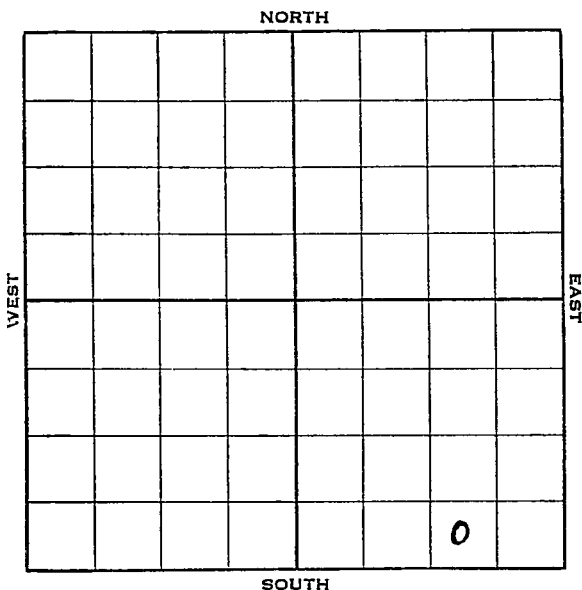

KANSAS

Stafford


Sec. 27 Twp. 21 R. 13-WWell No. #8 Gates FarmAtlantic Company

Ft. from N. Line

330 Ft. from S. Line990 Ft. from E. Line

Ft. from W. Line

Elev. 1877

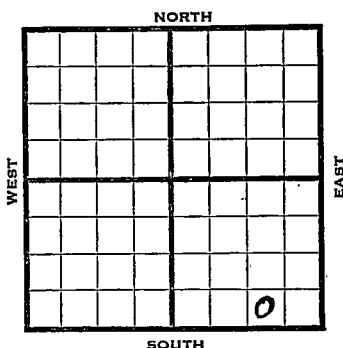

1938	REPORT
10/12	Location
10/21	R.U.R. 3604'. 2500' oil in 3 hrs.
10/28	10" - 269'. Anhy. 695'.
	Drlg. 1000'.
11/4	Drlg. 3102'.
11/12	Arb. 3652-53'. 7" - 3652'.
	RUST.
11/18	T. D. 3659'. 2500' oil in 3 hrs.
	2000 acid.
11/22	7" - 3652'.
	Arb. 3652'.
	T. D. 3659'.
	2000 acid.
	Pump 475 bbIs. 8 hours.
	Potential 1424 bbIs.
	COMPLETED

Stafford KANSAS

Map No. 82 Sec. 27 Twp. 21 R. 13WWell No. 8 GatesAtlantic

Company

Contractor

FIRST REPORT

SW SE SE

 Ft. from N. Line330 Ft. from S. Line990 Ft. from E. Line Ft. from W. Line

SECTION PLAT

			0

Location XRig up

Drilling and Remarks:

RECORD

Cased in., ft.Sand Gas Oil Total Depth

PRODUCTION

1st 24 hrs. Nat. 1st 24 hrs. after shot Gas Cu. Ft.Dry Hole Abandoned

Date

OCT 12 1938

19

H. D. Hatfield

Scout

Stafford KANSAS

Map No. 82 Sec. 27 Twp. 21 R. 13WWell No. 8 GatesAtlantic

Company

Contractor

COMPLETED

SECTION PLAT

SW SE SE

 Ft. from N. Line330 Ft. from S. Line990 Ft. from E. Line Ft. from W. Line

			0

Location Rig up

Drilling and Remarks:

2000 acidP-475/8POT 1424

RECORD

Cased 7 in., 3652 ft.Sand Arb 3652Gas Oil Total Depth 3659

PRODUCTION

1st 24 hrs. Nat. 1st 24 hrs. after shot Gas Cu. Ft.Dry Hole Abandoned

Date

NOV 2 - 193319H. D. Hatfield Scout