


Section 27 Township 21 Range 13W

Well No. #14 Gates

Company Atlantic

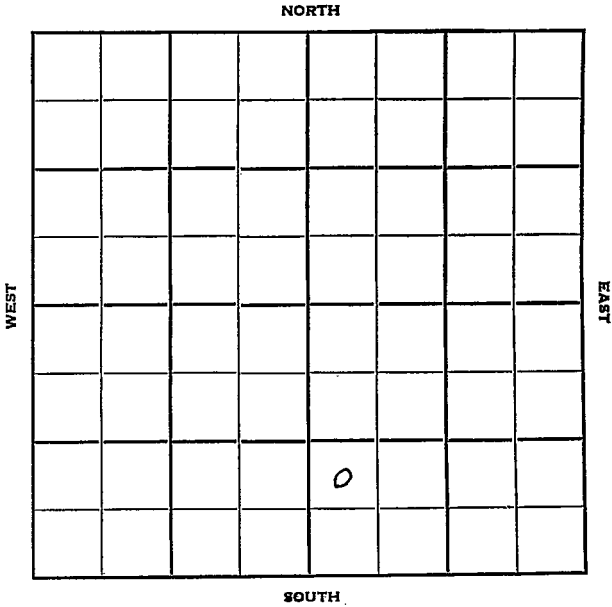

Stafford

KANSAS

Sec. 27 Twp. 21 R. 13 W

Well No. # 14 Gates Farm

Atlantic Company

Honaker Contractor

Gates


\_\_\_\_\_ Ft. from N. Line

990 Ft. from S. Line

\_\_\_\_\_ Ft. from E. Line

330 Ft. from W. Line

NW SW SE

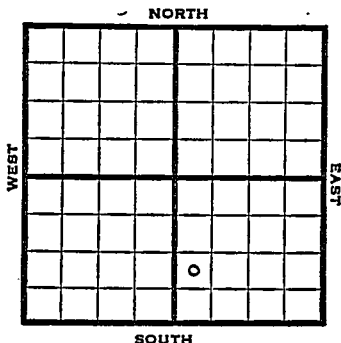

1951 Elev. 1882' REPORT

11/7 Location

1952  
1/2

Spud 11-11-51

D & A TD 3713' 8" @ 322

Heeb 3192' Br. lime 3323'

Lans. 3339'

DST 3468-86 open 1 hr. rec 14' mud

DST 3486-3503 open 1 hr. rec 12' mud

Viola 3599'

DST 3603-25 open 1 hr. rec 30' mud

Simp. 3648' Arb. 3704'

DST 3708-13 open 1 hr. rec 85' oil,  
60' HOCM, 40' SW

TD 3713' 5" @ 3707' B/5 GO 2 GWPB

250 A S/5 GW 8 GOPH PB 3710'

250 A S/5 GW 8 GO 5 hr.

2000 A S/3 1/2 BFPB 80% water.

PB 3660' 2 1/4/3493-98 500 A

S/17 BWFD 12 GOPD 2000 A

S/3 BFPB 99% water 2 1/4/3477-84 wtr.

SP 3488' CO to 3486' 20/3478-83

2000 A S/45 GW 2 GOPH

D & A

**ABANDONED**



