

Stafford


KANSAS

SECTION 27 TOWNSHIP 21S RANGE 13W

WELL NO. #17 Gates

COMPANY Atlantic Refg.

NORTH 70' ~~100'~~ E of C NE NW NE

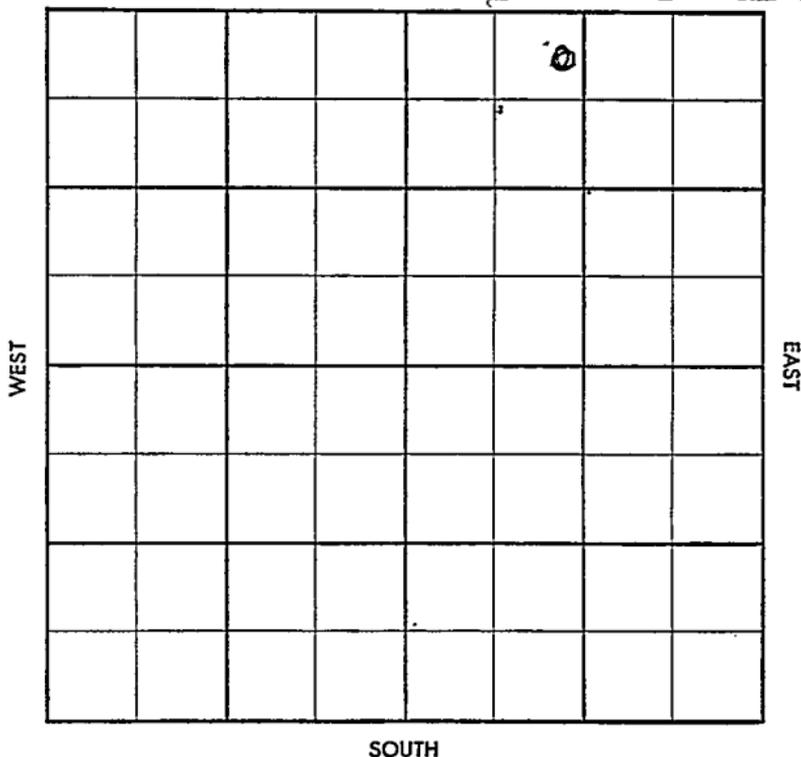

13

~~21~~

County Stafford Elev. \_\_\_\_\_

Sec. 27 Twp. 21 Rge. 13W

Company Atlantic Refg.

Farm Name Gates No. 17

TOPS	DEPTH	LOG	DATUM
Anh.			
Tp.			
H.			
Tr.			
Dg.			
B.L.			
L.			
K.C.			
B.K.C.			
Ce.			
C.			
M.			
M.			
K.			
Mz.			
Mq.			
V.			
S.			
S.			
A.			
R.			
Pf.			
G.			
T.D.			

Loc. in Sec. \_\_\_\_\_

100' E of C

of NE NW NE

Geol. \_\_\_\_\_

Contr. \_\_\_\_\_

Peel Bros.

Pool \_\_\_\_\_

Gates

JUN 29 1959

**FIRST REPORT**

Date Comm. \_\_\_\_\_

Location

\_\_\_\_\_

\_\_\_\_\_

\_\_\_\_\_

\_\_\_\_\_

\_\_\_\_\_

\_\_\_\_\_

\_\_\_\_\_

Co.

Lse.

No.

Sec.

T.

R.

Twp. ~~X~~ Pool ~~X~~  
 Co. ~~X~~ Facet ~~X~~  
 LUBRICATION

S-513-B

County Stafford Elev. 1475  
 Sec. 27 Twp. 21 Rge. 13W  
 Company Atlantic Ref.  
 Farm Name Gates No. 17

TOPS	DEPTH	LOG	DATUM
Anh.			
Tp.			
H.	3172	3172	
Tr.			
Dg.			
B.L.	3300	3302	
L.	3312	3315	
K.C.			
B.K.C.			
Ce.			
C.			
M.			
M.			
K.			
Mz.			
Mq.			
V.		3564	
S.		<del>3600</del> 3610	
S.			
A.		3666	
R.			
Pf.			
G.			
T.D.	3745		

Log in Sec. 100' E of C  
 of NE NW NE  
 Geol. \_\_\_\_\_  
 Contr. \_\_\_\_\_  
 Peel Bros.  
 Pool \_\_\_\_\_  
 Gates  
 MAY 28 '58  
 COMPLETE

Date Comm. 2-1-58 1034253/325  
 Location FEB 3 '58 WOL FEB 12 '58 DST 3328 -  
44 2 1/2" ga 810 m. / 15" oil in 14"  
3-5 BOPH FP 270-415 BHP  
1235-1195/30" FEB 10 DST  
3346-96 60" 2 1/3" 460 m. /  
F10 M / 13 F10 0/24" 6 BOPH  
see 40' oil 50' W FP 415-860  
BHP 1190-1145/30 DST 3392  
-3430 60" 50' MW FP 0-0 BHP  
1180-1000/30 DST 3447-82

Co.  
 Lsg.  
 No.  
 Sect.  
 T.  
 R.

60" 9 1/2" 240' gum  
400' W 160m 960' SW FP 190  
625 BHP 1190 - 685 1/2"

3645-89 60" 270' HOB gum  
5096 oil NW FP 30-75 BHP  
925 - 320/30" DST 3688-3714

60" 100' V HOB gum 80' fuel oil  
75' oil gum 25' mur FPO-60  
BHP 915-850/30" DST 3712-45  
60" 1860' SW 10g FEB 20 '79

7" 3745/200 MAR 5 '78 WOCT MAR 12 '79  
40/ 3684-94 # 3490 + 69W  
NT ~~20~~ (2) + 150B Ld oil \$ Ld  
\$ 112BW rainbow show

old Level 2100 S1 MAR 19 '78  
5p 3684-94 30 SKS 16/3674-78  
8/ 3669-70 # 1590 69W 3 1/2 hrs

mat (A) + oil Ld <sup>LOST Ld</sup> MAR 26 '78 CO 3694  
DST (100' parts) ~~(200' parts)~~ (3669-78) OP  
2 1/2 hrs ~~100~~ P 1080 in CSG rec

45' oil 30' W FPO-15 BHP 35 1/2"  
16/3684-88 # 6090 + 25 gW 5 hrs  
750A \$ 4BA + 19BW 9 hrs fld

Level 1800' from surface APR 1 '78  
\$ 3.5 BA + 16BW 5hr PB 3644  
60/3333-48 20/3356-61 20/  
3365-70 24/3384-90 457g APR 9 '78

F10 45 BA + 16 BW 3 1/2 hrs 1/2"  
CHK SICP 1060 TPO WO 7575

APR 16 '78 MAR 23 '78 P1780 + 129BW 20 hrs  
27-21-13W re new re

P 13 BD + 409W 2 hrs

APR 30 '58

MAY 7 '58

POT P 12 BOPD

+ 3 RBWpd in Arbuckle

MAY 14 '58

MAY 21 '58

MAY 26 '58

POT P 12 BOPD + 34 RBWpd

in Arb

~~3644~~ 3644

PKV 3644

2 zone pkvs 50 f

27-21-13W

ne nw ne

~~TOP~~ ~~Part~~  
~~Co.~~ ~~Part~~

S-513-B

County Stafford Elev. \_\_\_\_\_  
 Sec. 27 Twp. (21) Rge. 13W  
 Company Atlantic  
 Farm Name R. C. Gates No. 17

TOPS	DEPTH	LOG	DATUM
Anh.			
Tp.			
H.			
Tr.			
Dg.			
B.L.			
L.			
K.C.			
B.K.C.			
Ce.			
C.			
M.			
M.			
K.			
Mz.			
Mq.			
V.			
S.			
S.			
A.			
R.			
Pf.			
G.			
T.D.			

Loc. in Sec. \_\_\_\_\_  
100' E of  
NE NW NE  
 Geol. \_\_\_\_\_  
 Contr. \_\_\_\_\_  
 Pool \_\_\_\_\_  
Gates

**COMPLETE**  
 JUN 11 1958  
**FIRST REPORT**

Date Comp. \_\_\_\_\_  
Additional Information: KC State Pot. Flow  
32 BOPD + 1% wtr 13/64" ch. Dual Comp.  
LKC & Arb.

Co.  
 Lse.  
 No.  
 Sec.  
 T.  
 R.