

Section 27 Township 21 Range 14WWell No. #1 PileCompany Phillips Pet.

NORTH

				0			

SOUTH

WEST

EAST

Stafford

KANSAS

Sec. 27 Twp. 21 R. 14 W. ✓

Well No. # 1 Pile Farm

Phillips Pet. Company

Armer Drlg. Contractor-

Hickman Pool

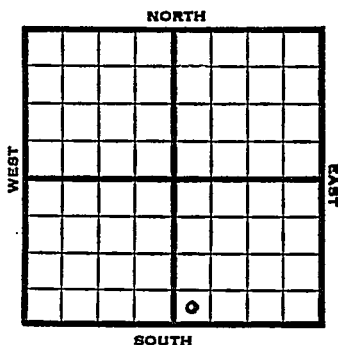
Ft. from N. Line

330 Ft. from S. Line

Ft. from E. Line

330 Ft. from W. Line

SW SW SE



1951

Elev. 1939

REPORT

3/14

Location

5/9

Spud 3-17-51

Oil Well TD 3803

8" @ 416 Heeb. 3271

Tor. 3302 Br Lime 3397

Lans. 3407 Cong. 3672

Viola 3680 Simp 3719

Sand 3743 Arb. 3769

TD 3803 5" @ 3793

CO to 3775 48/3531-42

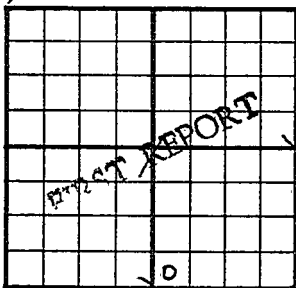
B/5 bo tr wtr 6 hr. 1500"

F/45 bo 1 hr s/199 bo

4 hr P & F/220 bopd

Comp. draw down pot. 2160 bopd

COMPLETED

County Stafford State KansasSec. 27 (Blk. 21 (Sur. 14W Map No. 21 (Rge. 14W)Operator Phillips Pet.Well No. 1 Farm PileElev. 1939 Location SW SW SE330 Ft. From S Line SE330 Ft. From W Line Quarter1st. Report MAR 1 4 1951

Completion

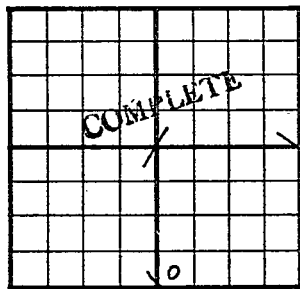
Remarks

Armer Drlg. - Contr.

Spudding Date

Drlg. Data Hickman PoolLocation

J. E. TYRA

County Stafford State KansasSec. 27 (Blk. 21 (Sur. 14W Map No.)
(Twp.) (Rge.)Operator Phillips Pet.Well No. 1 Farm PileElev. 1939 Location SW SW SE330 Ft. From S Line SE330 Ft. From W Line Quarter1st. Report Completion MAY 9 1951Remarks Hickman PoolArmer Drlg. - Contr.Spudding Date 3-17-51Drlg. Data Oil well TD 38038" @ 416 Heeb. 3271 Tor. 3302Br. lime 3397 Lans. 3407 Cong. 3672Viola 3680 Simp. 3719 Sand 3743Arb. 3769 TD 3803 5" @ 3793CO to 3775 .48/ 3531-42 B/ 5 bo tr. water6 hr. 1500 " F/ 45 bo 1 hr. S/ 199 bo4 hr. P & F/ 220 bopdComp. draw down pot. 2160 bopd

J. E. TYRA