


Section 27 Township 21 Range 14 W

Well No. # 1 Keenan "B"

Company Anderson-Prichard

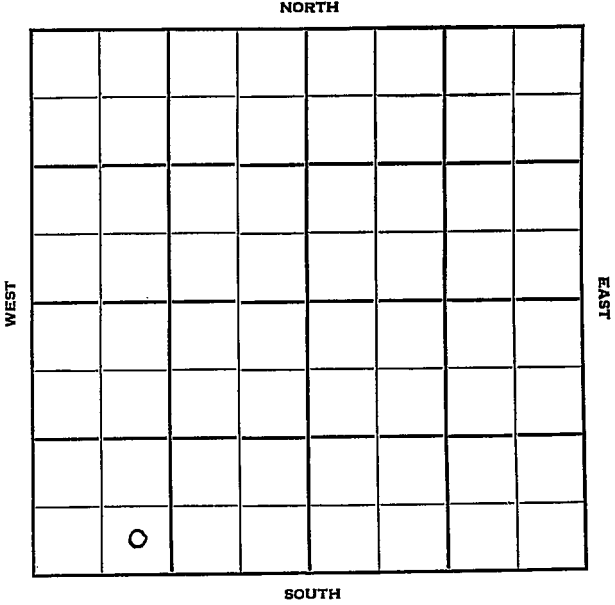

Sec. 27 Twp. 21 R. 14W

Well No. #1 Keenan "B" Farm

Anderson-Prichard Company

B & B Drlg. - Contr. Contractor

Hickman Pool


_____ Ft. from N. Line

330' Ft. from S. Line

_____ Ft. from E. Line

990' Ft. from W. Line

SE SW SW

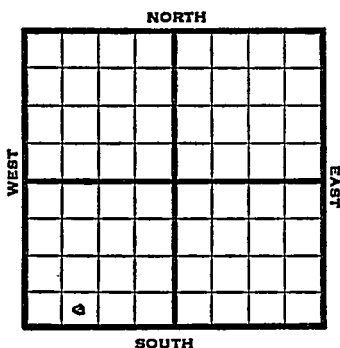

1951

Elev. 1945' REPORT

3/28

Spud 3-28-51

4/18

Spud 3-29-51

D&A TD 3835

8" @ 424

Anhy 857' Heeb. 3294

Br Lime 3416 Lans. 3427

DST 3544-57 opn 50 min

Rec. 315' sw

DST 3587-97 opn 1 hr

Rec. 40' wtr Viola 3701

Simp. 3742 Sand 3763

DST 3740-76 opn 1 hr

Rec. 40' mud Arb. 3799

TD 3835 D&A

ABANDONED

