


Section 27 Township 21 Range 11W

Well No. #3 Keenan (B)

Company Anderson & Pritchard

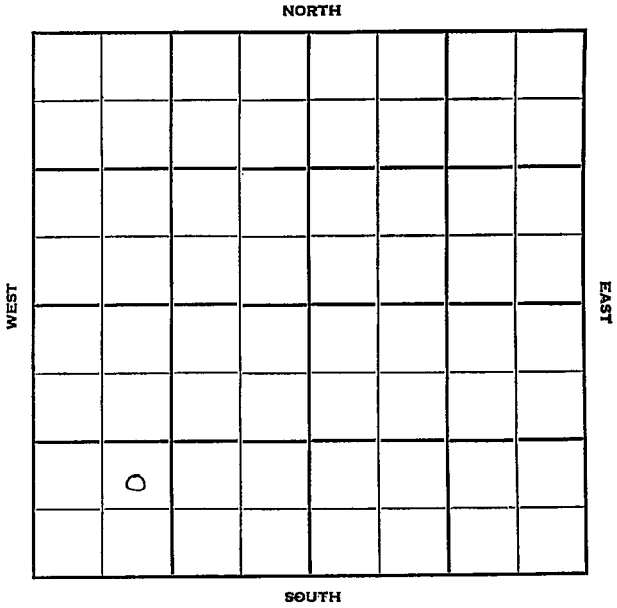

Stafford

KANSAS

Sec. 27 Twp. 21 R. 14W

Well No. #3 Keenan (B) Farm

Anderson-Prichard Company

Hickman Contractor


           Ft. from N. Line

990 Ft. from S. Line

           Ft. from E. Line

990 Ft. from W. Line

NE SW SW

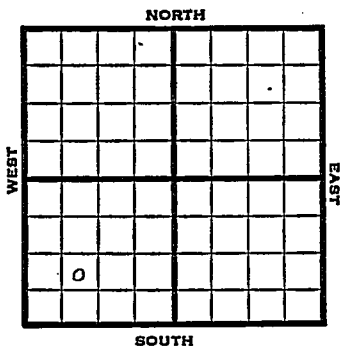

1951

Elev. 1941'

REPORT

10/10

Location

10/24

Spud 10-10-51  
D&A TD 3837  
8" @ 495  
Heeb. 3290 Br. lm. 3410  
Ians. 3420  
DST 3536-54 open 45 min.  
Rec. 120' SW & Tr. oil  
60' wtr. & mud 120' SW  
DST 3576-94 open 1/2 hr.  
Rec. 5' mud  
Cong. 3694 Viola 3700  
Simp. sh. 3736 Simp. sd. 3750.  
DST 3754-65 open 1/2 hr.  
Rec. 30' mud  
Arb. 3787  
TD 3837  
D&A

**ABANDONED**



