


Section 27 Township 21 Range 11 WWell No. # 3 Ratcliff *(Ratzliff)*Company Crown Oil ?

NORTH

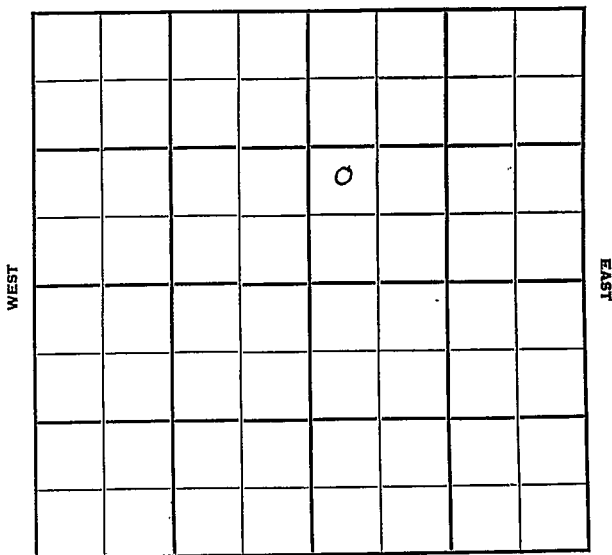

SOUTH

Stafford

KANSAS

Sec. 27 Twp. 21 R. 14 W

Well No. # 3 Ratcliff Farm

Crown Oil Company

Hilton Contractor

Van Winkle Pool


NORTH

Ft. from N. Line

990 Ft. from S. Line

Ft. from E. Line

330 Ft. from W. Line

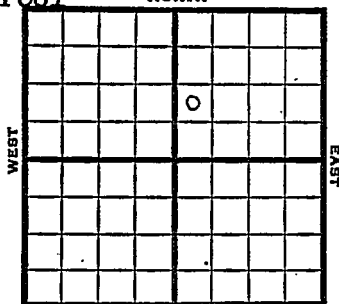

NW SW NE

SOUTH

1951	Elv. 1936' REPORT
4/18	Spud 4-16-51 8" @ 263 Drlg. 710'
5/2	Spud 4-16-51 D&A TD 3620 8" @ 263 Anhy 830 Heeb. 3295 Br Lime 3413 Lans. 3423 DST 3539-58 opn 45 min. Rec. 115' wtr & mud TD 3620' D& ABANDONED

County Stafford State Kansas
 Sec. 27 (Blk. 21) (Sur. 14W) Map No. 14W
 Operator Crown Oil
 Well No. 3 Farm Ratcliff
 Elev. _____ Location NW SW NE

990 Ft. From S Line NE
330 Ft. From W Line Quarter

1st. Report APR 18 1951

Completion _____

Remarks _____

Hilton - Contr.

Spudding Date 4-16-51

Drlg. Data Van Winkle Pool

8" @ 263 drlg. 710

J. E. TYRA