Form 51-5M-12-36 Com'l


Rice

KANSAS

Section 27 Township 21 Range 8-W

Well Number 1 Mathes

Company Mansing & Martin et al

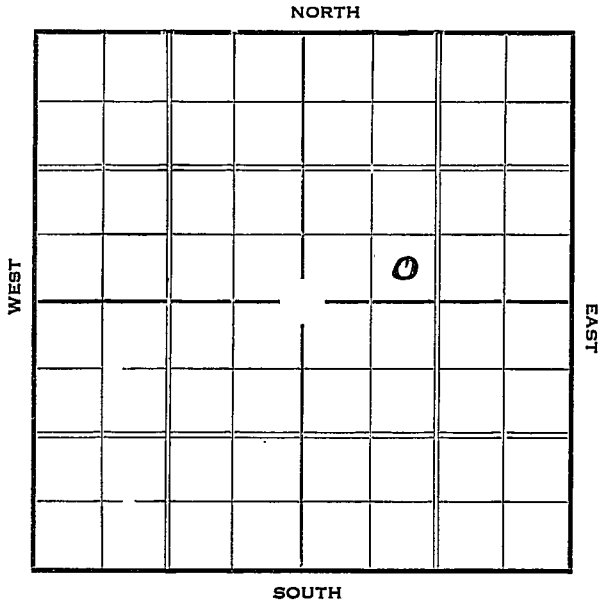


Form 252-A—5M—7-36—Palace KANSAS Rice

Sec. 27 Twp. 21 R. 8-W

Well No. #1 Mathes Farm

Manning & Martin et al Company

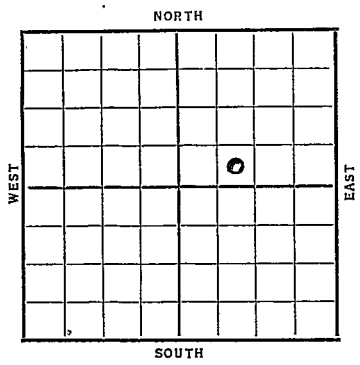


____ Ft. from N. Line

330 Ft. from S. Line

____ Ft. from E. Line

990 Ft. from W. Line

| Date 1937 | REPORT |
|---|---|
| 2/3 | Location |
| 2/4 | |
| 2/11 | ROG " |
| 2/18 | Rig |
| 2 ,26 | Rigging up. |
| 3/4 | Surface hole |
| 3/11 | 12" @ 239'. Drlg. 2325'. |
| 3/18 | Topeka 2460', Lansing 2945' |
| | Conglomerate 3323'. Coring 3333' |
| 3/25 | Viola 3584'. Simpson 3645'. |
| | Drlg. 3685'. |
| 4/2 | Shut Down 3685'. |
| | |
| | |
| 4/7 | Sil. 3685'. |
| | T. D. 3710'. |
| | Hole full water. |
| | |
| | ABANDONED |
| | |
| | |
| | |

Form 26—1M Bks.—2-29 KANSAS


Map No. 49 Sec. 27 Twp. 21 R. 8W

Well No. 1 Mathes

Manning & Martin et al Company

Contractor

SECTION PLAT

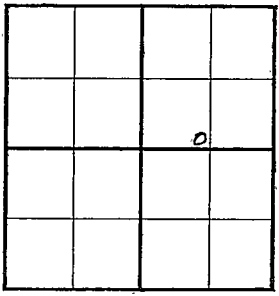

____ Ft. from N. Line

330 Ft. from S. Line

____ Ft. from E. Line

990 Ft. from W. Line

FIRST REPORT

Location ✓

Rig up

Drilling and Remarks:

**RECORD**

Cased ____ in., ____ ft.

Sand

Gas

Oil

Total Depth

**PRODUCTION**

1st 24 hrs. Nat.

1st 24 hrs. after shot

Gas ____ Cu. Ft.

Dry Hole

Abandoned

Date

FEB 3 1937 19 S. J. LEWIS Scout

Form 26—1M Bks. 2-29 KANSAS Rice


Map No. Sec. 27 Twp. 21 R. 8W.

Well No. 1 Mathes

Manning & Martin et al Company

Contractor

SECTION PLAT

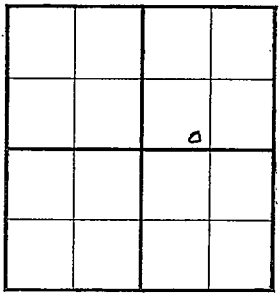

Ft. from N. Line

330 Ft. from S. Line

Ft. from E. Line

990 Ft. from W. Line

ABANDONED

Location

Rig up

Drilling and Remarks:

S.I. 3685.

HFW

RECORD

Cased in., ft.

Sand

Gas

Oil

Total Depth 3710

PRODUCTION

1st 24 hrs. Nat.

1st 24 hrs. after shot

Gas Cu. Ft.

Dry Hole ✓

Abandoned ✓

Date

AUG [illegible] 19

S. J LEWIS Scout