


Section 27 Township 21 Range 16 W

Well No. # 1 Bell

Company Gulf Oil

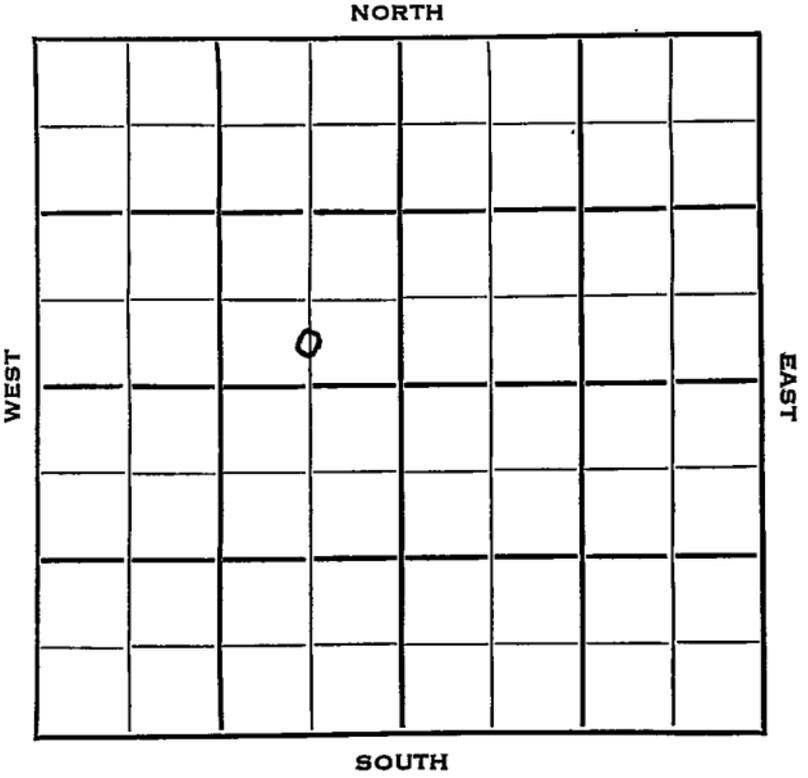

Sec. 27 Twp. 21 R. 16 W

Well No. # 1 Bell Farm

Gulf Oil Company

Barbour Drlg. Contractor

Larned Pool


_____ Ft. from N. Line

330 Ft. from S. Line

660 Ft. from E. Line

_____ Ft. from W. Line

C S L SE NW

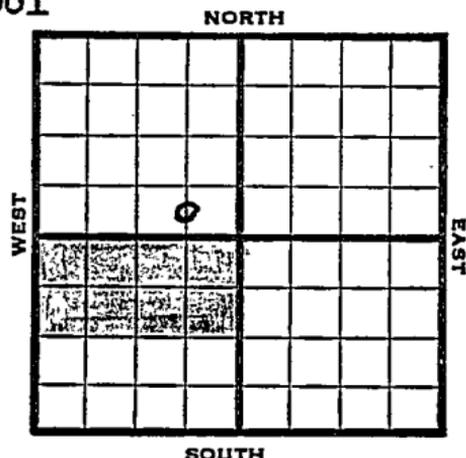

1953

Elev. 1990' REPORT

5/13 Spud 5-9-53
8" @ 991
Anhy 987'
Drilling

*3562
3380
3362*

5/21 Drlg. 3640'

5/28 Heeb 3391, Tor 3410, Br L. 3489, Lans 3500, Simp 3803, Arb 3862, RTD 3866
5" @ 3863 CO 3866 FU 2000' oil 3 hrs.

6/3 S/146 BO 3 hrs., 500A
S/121 BO 2 hrs., 1500' OB, POP

6/10 NR

6/25 Completed for a potential of 2779 BOPD plus 5% water (Ltr-McGehee)

6/24 Spud 5-9-53 Oil well TD 3866
8" @ 991 Anhy 987 Heeb 3391
Tor. 3410 Br line 3489 Lans 3500
Simp. 3803 Arb. 3862 TD 3866
5" @ 3863 CO to 3866 FU 2000' oil 3 hr. S/146 BO 3 hr. 500 A
S/121 BO 2 hr.
Comp. 2779 BOPD 5% wtr.

*3862
1990
1872*

COMPLETED

