


Section 27 Township 21 Range 16 W

Well No. # 4 Bell

Company Gulf Oil

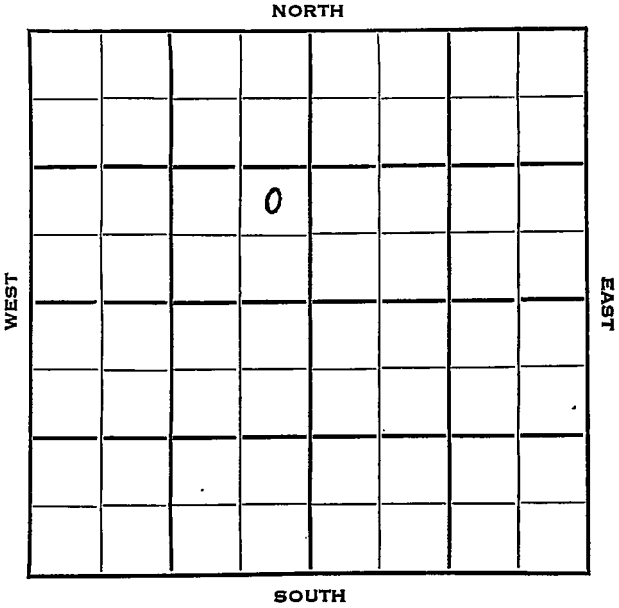

Sec. 27 Twp. 21 R. 16 WWell No. # 1 Bell FarmGulf Oil

Company

Barbour

Contractor


Larned Pool

Ft. from N. Line

990 Ft. from S. Line330 Ft. from E. Line

Ft. from W. Line

NE SE NW

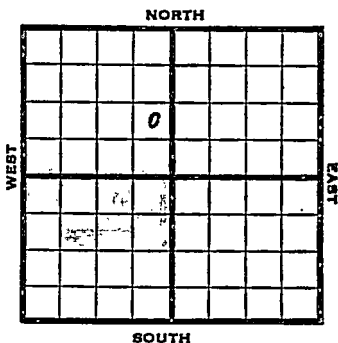

1953

Elev. 1989' REPORT

- 8/5 Spud 7-28-53
13" @ 120 8" @ 992
Anhy 987'
Drlg. 3165'
- $$\begin{array}{r} 3868 \\ 1989 \\ \hline 1879 \end{array}$$

$$\begin{array}{r} 3868 \\ 3499 \\ \hline 369 \end{array}$$
- 8/13 Heeb 3390' Tor. 3407' Br. line 3489'
Lans. 3499' Gong. 3769' Simp 3806
Simp. sd. 3858' Arb. 3868'
5" @ 3869' (Ltr-McGehee)
- 8/20 CO to 3870' FU 215' oil S/10 $\frac{1}{2}$ BO
5 hr. 300 A S/89 BO 1 $\frac{1}{4}$ hr, 1870'
off bottom, S/49 BO 3/4 hr.
Shut in 3 hr. FU 3300' oil.
(Ltr-McGehee)
- 8/27 S/151 BO in 3 hrs. 3000' off
bottom. POP (Ltr-McGehee)
- 8 9/2 N.R.
- 9/9 Completed for a state potential of
3000 bopd (Ltr-McGehee)
- 9/9 Spud 7-28-53 Oil well TD 3870
13" @ 120 8" @ 992 Anhy 987
Heeb 3390 Tor 3407 Br li 3489
Lans 3499 Gong 3769 Simp 3806
Simp sd, 3858' Arb. ~~368~~ 3868'
TD 3870' 5" @ 3869 CO to 3870
FU 215' oil S/10 $\frac{1}{2}$ BO 5 hr. 300 A
S/89 BO 1 $\frac{1}{4}$ hr. S/49 BO 3/4 hr.
Shut in 3 hr. FU 3300' oil S/151 BO
3 hr. Comp. 3000 BOPD. **COMPLETED**


Sec. **27** (Blk. Twp.) **21** (Sur. Rge.) **16W** Map No.

Operator **Gulf Oil**

Well No. **4** Farm **Bell**

Elev. **1989** Location **NE SE NW**

990 Ft. From **S** Line **NW**

330 Ft. From **E** Line **Quarter**

Ist. Report **4UG 5 1953**

Completion

Remarks

Barbour - Contr.

Spudding Date **7-28-53**

Drlg. Data **Larned Pool**

13th @ 120 8th @ 992 Anhy 987 drlg. 3165


County Pawnee State Kansas

Sec. 27 (Blk. Twp.) 21 (Sur. Rge.) 16W Map No.

Operator Gulf Oil

Well No. 4 Farm Bell

Elev. 1989 Location NE SE NW

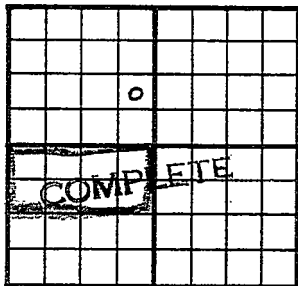

990 Ft. From S Line NW

330 Ft. From E Line Quarter

1st. Report

Completion SEP 9 1953

Remarks Larned Pool

Barbour - Contr.

Spudding Date 7-28-53

Drlg. Data Oil well TD 3870

13" @ 120 8" @ 992 Anhy 987

Heeb. 3390 Tor. 3407 Br. lime 3489

Lans. 3499 Cong. 3769 Simp. 3806

Simp. sd. 3858 Arb. 3868 TD 3870

5" @ 3869 CO to 3870 FU 215' oil

S/ 10 1/2 bo 5 hr. 300 A S/ 89 bo 1 1/4 hr.

S/ 49 bo 3/4 hr. shut in 3 hr.

FU 3300' oil S/ 151 bo 3 hr.

Comp. 3000 bopd

J. G. MCGEHEE