


Section 27 Township 21 Range 16W

Well No. #5 Bell

Company Gulf Oil

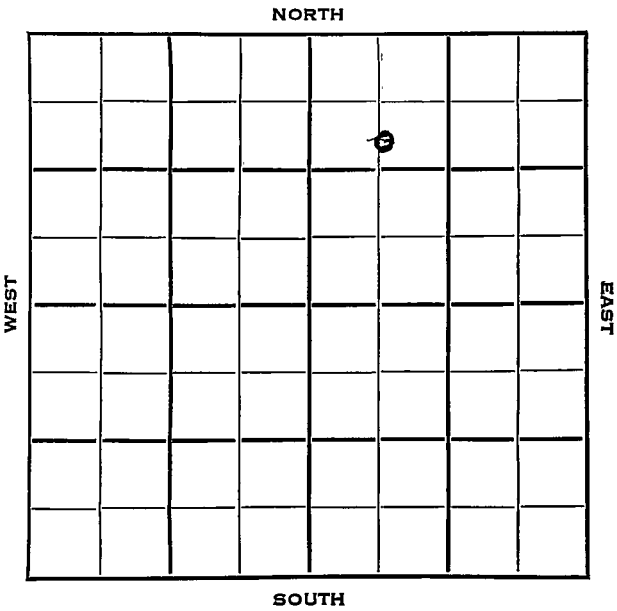

HOT FILE

Pawnee

Sec. 27 Twp. 21 R. 16WWell No. #5 Bell FarmGulf Oil

Company

Contractor


Larned Pool

Ft. from N. Line

1650 Ft. from S. Line1910 Ft. from E. Line

Ft. from W. Line

SE NW NE

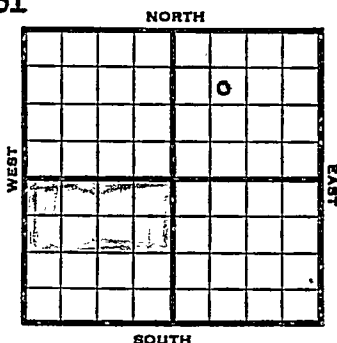

1953 Elev. 1985' REPORT

8/19 Location
 8/26 8" @ 13" @ 106 w/116 Anhy 982'
 8/27 Drig. 2640' (Ltr-McGehee)

9/2 8" @ 990'
 Heeb. 3384', Tor 3405', Br. L. 3484',
 Lans 3494', Cong 3765, Simp 3809'
 Arb 3868'
 RTD 3870'

9/9 5" @ 3869' C.O. 3870'

9/16 B/30 GOPH, 300A
 S/25 BOPH 4 hrs.

9/23 NR


9/30 Spud 8-17-53 Oil well TD 3870'
 13" @ 106 Anhy 982' 8" @ 990
 Heeb 3384 Tor. 3405 Br line 3484'
 Lans. 3494' Cong. 3765 Simp 3809
 Arb. 3868' TD 3870 B/30 GOPH
 300 A S/25 BOPH 4 hr.
 Comp. 231 BOPD

COMPLETED

$$\begin{array}{r} 3868 \\ 1585 \\ \hline 1883 \end{array}$$

$$\begin{array}{r} 3868 \\ 3494 \\ \hline 374 \end{array}$$

J. G. McGEHEE

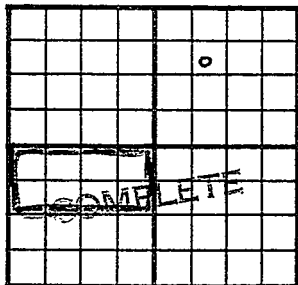County Pawnee State KansasSec. 27 (Blk.
Twp.) 21 (Sur.
Rge.) 16W Map No.Operator Gulf OilWell No. 5 Farm BellElev. 1985 Location SE NW NE1650Ft. From S Line NE1910Ft. From E Line Quarter1st. ReportCompletion SEP 30 1953Remarks Larned PoolSpudding Date 8-17-53Drlg. Data Oil well TD 387013" @ 106 Anhy. 982 8" @ 990Heeb. 3384 Tor. 3405 Br. lime 3484Lans. 3494 Cong. 3765 Simp. 3809Arb. 3868 TD 3870 B/ 30 goph 300 AS/ 25 boph 4 hr. Comp. 231 bond

J. G. McGEHEE