


Section 27 Township 21 Range 16W

Well No. #1 Larned Unit

Company Sunray Oil Corp

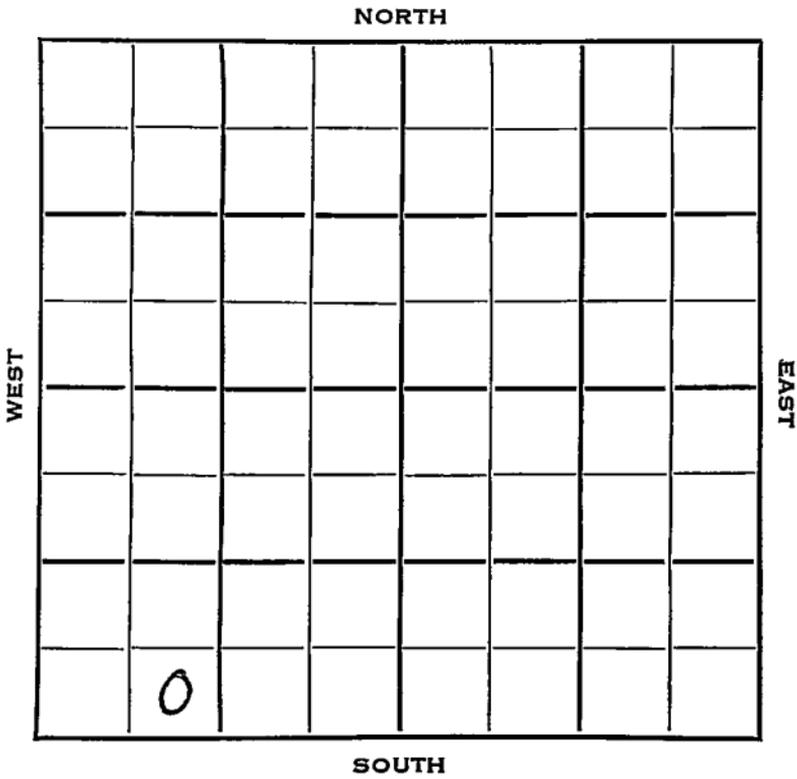

Pawnee

KANSAS ✓

Sec. 27 Twp. 21 R. 16 W

Well No. # 1 Larned Unit Farm _____

Sunray Oil Corp. Company

Stickle Drlg. Contractor
Larned Pool


_____ Ft. from N. Line

330 Ft. from S. Line

_____ Ft. from E. Line

990 Ft. from W. Line

SE SW SW

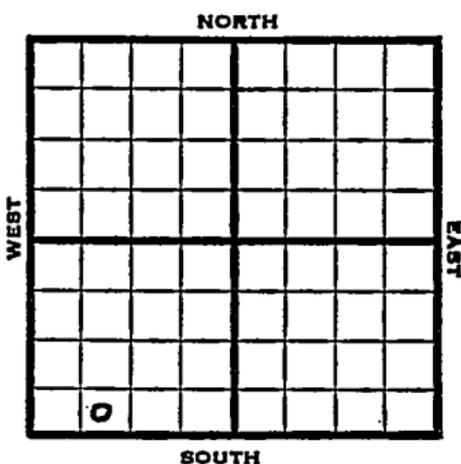

1953 Elev. 1992' REPORT

5/6 Spud 5-1-53
8" @ 984
Drlg. 1525'

5/21 Heeb 3389, ^Tor 3413; Br li 3486;
Lans 3496, B KC 3713, Cong 3789, Simp
sha 3811, Arb 3847
RTD 4850
5" @ 3848
CO 3850, FU 2000' oil 20 mins.
DD 3853, FU 3400' oil 1 hr.,
S/40 BOPH, DD 3856 TD

*3847
3496

351*

5/28 N.R.

6/3 Spud 5-1-53 Oil well TD 3856'
8" @ 984' Heeb 3389 Tor 3413
Br line 3486 Lans 3496 B KC 3713
Cong 3789 Simp 3811 Arb. 3847
TD 3850 5" @ 3848 CO to 3850
FU 2000' oil 20 min DD 3853
FU 3400' oil 1 hr S/40 BOPH
DD 3856
Comp. 3000 BOPD

*3847
1942

1855*

COMPLETED

