

KANSAS

Company Champlin Ref.

WEST

EAST

D

SOUTH

Sec. 27 Twp. 21 R. 16^W

Well No. #1 Miles Farm

Champlin Ref. _____ Company

Contractor


Ft. from N. Line

330 Ft. from S. Line

Ft. from E. Line

330 Ft. from W. Line

SW SW SE

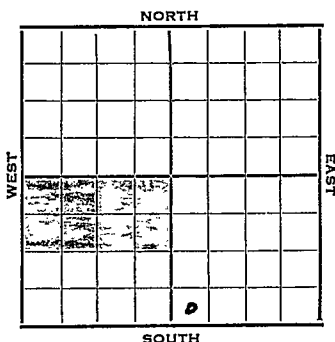

1953	Elev. 1991'	REPORT
------	-------------	--------

2/4	Location
-----	----------

2/12 Spud 2-10-53

2/19	8" @ 1010 Dr1g. 3165'
------	--------------------------

2/27 Heebner 3391' Br. lime 3489'
Lans. 3501'
DST 3520-49, open 1/2 hr, rec 10'
mud. Arbuckle 3864'

DST 3864-69 open 1 hr, rec 2886'
clean oil, 20' HO & GCM
TD 3869' 5" @ 3863'. (Wire)

3/2 CO to 3867'. Corrected TD.
FU 2915' oil 1 hr.
S/55 BOPH, 2000' off bottom
Setting tanks & pumping unit. (Card)

3/5	Swabbed 81 B0 1½ hr, Gr. 38. (Ltr)
-----	------------------------------------

3/12 5" @ 3863
CO 3869
FU 2915' oil, 1 hr.
S/55 BOPH
S/81 BO 1½ hrs., G 38, POP

3/19 Completed for 3000 BOPD (Ltr) -

3064

JVER

#1 Miles

1953
3/18

Spud 2-10-53

Oil Well

TD 3867

8" @ 1010

Heeb 3391, Br lime 3489,

Lans 3501

DST 3520-49, opn $\frac{1}{2}$ hr., rec.

10' mud, 0#

Arb 3862

DST 3862-69, opn 1 hr., rec.

2885' clean oil, 20' ho & gcm,

250#

TD 3867

5" @ 3863

CO to 3867


FU 2915' oil 1 hr., S/55 boph

S/81 bo-1 $\frac{1}{2}$ hrs.

Comp. 3000 bopd

COMPLETED

County Pawnee State Kansas
 Sec. 27 (Blk. 21 (Sur. 16W Map No.
 (Twp.) (Rge.)
 Operator Champlin Ref.
 Well No. 1 Farm Miles
 Elev. Location SW SW SE

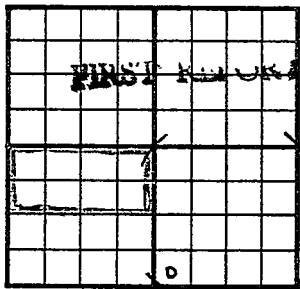


330 Ft. From S Line SE
330 Ft. From W Line Quarter
 Ist. Report FEB 4 1953
 Completion
 Remarks
 Spudding Date

Drlg. Data

Location

J. G. McGEHEE

County Pawnee State Kansas
 Sec. 27 (Blk. 21) (Sur. 16W) Map No. 21
 Operator Champlin Ref.
 Well No. 1 Farm Miles 1
 Elev. 1991 Location SW SW SE

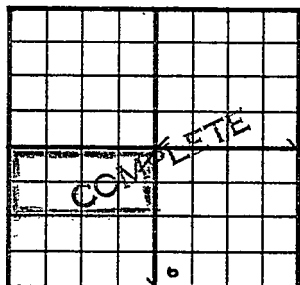

330 Ft. From S Line SE
330 Ft. From W Line Quarter
 1st. Report Completion MAR 18 1953
 Remarks Musgrove - Contr.
 Spudding Date 2-10-53

Drilg. Data Oil well TD 3867
8" @ 1010 Heeb. 3391 Br. lime 3489
Lans. 3501 DST 3520-49 open $\frac{1}{2}$ hr.
Rec. 10' mud 0# Arb. 3862 DST 3864-69
open 1 hr. Rec. 2885' clean oil
20' ho. & gcm 250# TD 3867 5" @ 3863
CO to 3867 FU 2915' oil 1 hr.
S/ 55 boph S/ 81 bo $1\frac{1}{2}$ hr.
Comp. 3000 bopd