


Section 27 Township 21 Range 16W

Well No. #2 Miles

Company Champlin Refining Company

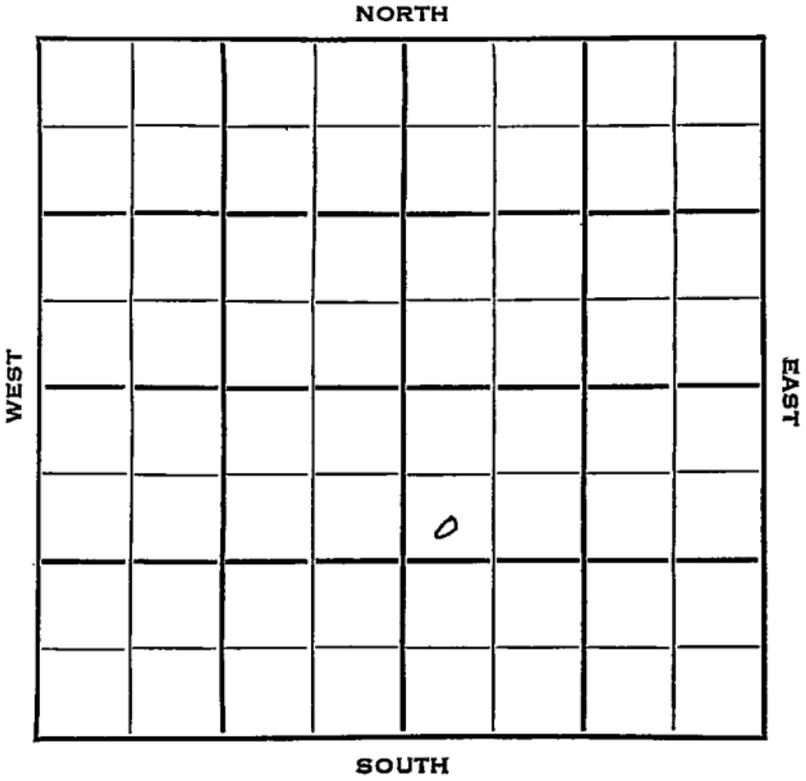

HOT FILE

Pawnee KANSAS ✓

Sec. 27 Twp. 21 R. 16 W

Well No. # 2 Miles Farm _____

Champlin Ref. Company _____


Contractor _____

990 Ft. from N. Line

_____ Ft. from S. Line

_____ Ft. from E. Line

330 Ft. from W. Line

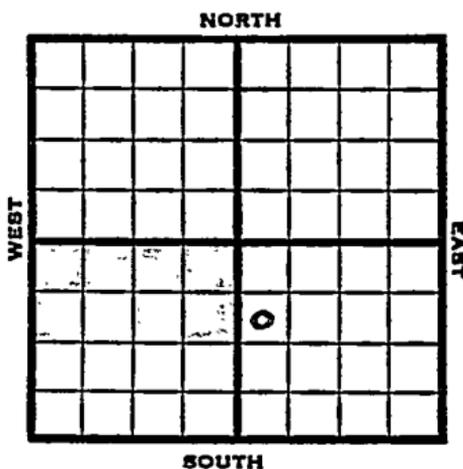

SW- NW SE

MCPC has N/2 SW of 27

1953 Elev. 1990' REPORT

- 3/4 Location
- 3/5 Spud 3-5-53
Drlg. 40' (Ltr)
- 3/12 Spudded 3-5-53
Anhy 983'
8" @ 990
Drlg. 2875' "
- 3/16 Arb. 3860' (Card)
- 3/19 Spudded 3-5-53
Anhy 983' 8" @ 990 Heeb 3390
Br line 3489' Lans 3500' Cong 3788
Arb. 3860'
TD 3862' Setting 5" @ 3861 (Ltr)
- 3/26 TD 3862' CO to 3862' FU 800'
oil 1 hr. S/8 BO 1 hr. DD 3865'
FU 3000' oil 4 hr. S/9 1/4 BO 2 1/4 hrs.
S/30 BO 1 hr. Lowered fluid to 1200'
off bottom. Putting on pump. (Ltr)
- 4/2 Completed to State Pot. of 3000 BPD
(Tel)

*3560
3330
3*

OVER

1953

4/1

Spud 3-5-53

Oil well TD 3865' Anhy 983' 2
8" @ 990 Heeb 3390 Br lime 3489'
Lans. 3500 Cong. 3788 Arb. 3860
TD 3862 5" @ 3861 CO to 3862
FU 800' oil 1 hr. S/8 BO 1 hr.
DD 3865 FU 3000' oil 4 hr.
S/94 BO 24 hr. S/30 BO 1 hr.
Comp. 3000 BOPD Gr. 38

COMPLETED


County Pawnee State Kansas

Sec. 27 (Blk.) 21 (Sur. Rge.) 16W Map No.

Operator Champlin Ref.

Well No. 2 Farm Miles

Elev. 1990 Location SW NW SE

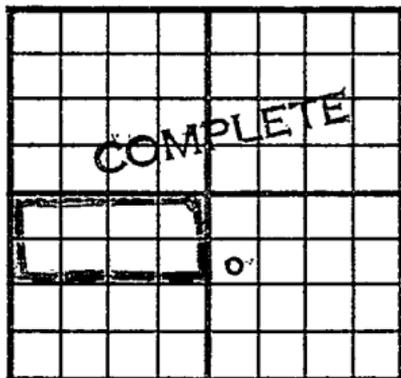

990 Ft. From N Line SE

330 Ft. From W Line Quarter

Ist. Report

Completion APR 1 1953

Remarks

Garvie - Contr.

Spudding Date 3-5-53

Drlg. Data Oil well TD 3865

Anhy 983 8" @ 990 Heeb. 3390

Br. lime 3489 Lans. 3500 Cong. 3788

Arb. 3860 TD 3862 5" @ 3861

CO to 3862 FU 800' oil 1 hr.

S/ 8 bo 1 hr. DD 3865 . FU 3000' oil

4 hr. S/ 94 bo 24 hr. S/ 30 bo 1 hr.

Comp. 3000 bopd. gr. 38