

Pawnee

DX 78-1

KANSAS

Section 27 Township 21 Range 16W

Well No.            # 1 Miles           

Company            Champlin Ref.

NORTH


WEST

EAST

SOUTH

# HOT FILE Pawnee KANSAS

SEQ. # 27      TWP. 21      R. 16 W


WELL NO. \_\_\_\_\_  
 # 4 Miles \_\_\_\_\_ FARM

COMPANY \_\_\_\_\_  
 Contractor Champlin Ref.

CONTRACTOR \_\_\_\_\_

## Larned Pool

\_\_\_\_\_ Ft. from N. Line  
990 \_\_\_\_\_ Ft. from S. Line  
 \_\_\_\_\_ Ft. from E. Line  
990 \_\_\_\_\_ Ft. from W. Line

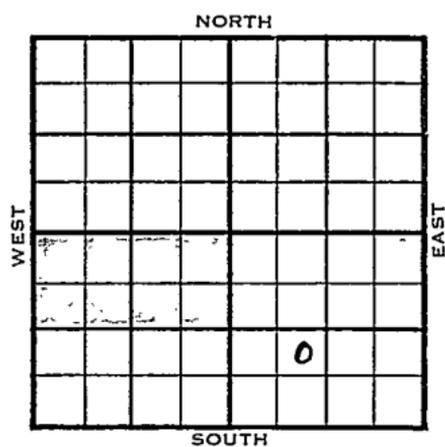

NE SW SE

	ELEVATION	REPORT
1954	1989'	

4/27	RUR	
5/5	8" @ 978' w/500 sks	Drlg. 2280'
5/12	7" @ 1035'	
5/19	Heeb 3388', Br. L. 3489', Lans 3499'	B KC 3737' Drlg 3765'
5/26	Arb. 2865'	RTD 3868' 4 1/2" @ 3866' CO 3868' CO 3868'
6/2	B/5 goph 8 hrs.	B/5 bfph 40% wtr. 7 hrs.
6/23	500A	S/42 1/2 bf 35% wtr 11 hr., S/23 BO + 15 BW 11 hrs.
	Spud 4-29-54	Oil well TD 3868
	8" @ 978	Heeb 3388 Br. lime 3489
	Lans. 3499	B KC 3737 Arb. 3865
	TD 3868	4 1/2" @ 3866 CO to 3868
	B/5 GOPH 8 hr.	B/5 BFPH 40% wtr.
	500 A	S/42 1/2 BF 35% wtr. 11 hr.
	S/23 BO	15 BW 11 hr. S/45 BO 16 BW
	12 hr.	SI 6 days B/39 BF 6% wtr.
	Comp. 77	BOPD 36 BW

**COMPLETED**


County Pawnee State Kansas

Sec. 27 (Blk. 21 (Sur. 16W (Twp.) (Rge.) Map No.

Operator Champlin Ref.

Well No. 4 Farm Miles

Elev. \_\_\_\_\_ Location NE SW SE

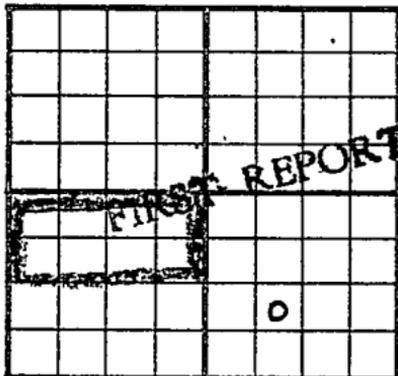

990 Ft. From S Line SE

990 Ft. From W Line Quarter

Ist. Report APR 27 1954

Completion \_\_\_\_\_


Remarks \_\_\_\_\_

Spudding Date \_\_\_\_\_

Drlg. Data Larned Pool

RUR

County Pawnee State Kansas  
 Sec. 27 (Blk.) 21 (Sur.) 16W Map No.  
 Operator Champlin Ref.  
 Well No. 4 Farm Miles  
 Elev. 1989 Location NE SW SE

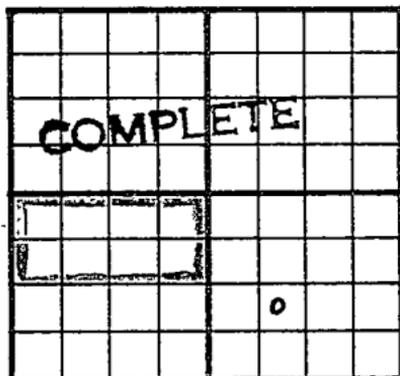

990 Ft. From S Line SE  
990 Ft. From W Line Quarter

Ist. Report

Completion JUN 23 1954

Remarks Larned Pool

Spudding Date 4-29-54

Drlg. Data Oil well TD 3868

8" @ 978 Heeb. 3388 Br. lime 3489

Lans. 3499 B KC 3737 Arb. 3865

TD 3868 4 $\frac{1}{2}$ " @ 3866 CO to 3868

B/ 5 goph 8 hr. B/ 5 bfph 40% wtr.

500 A S/ 42 $\frac{1}{2}$  bf 35% wtr. 11 hr.

S/ 23 bo 15 bw 11 hr. S/ 45 bo 16 bw

12 hr. SI 6 days B/ 39 bf 6% wtr.

Comp. 77 bopd. 36 bw

J. G. McGEHEE