


Pawnee

Section 27 Township 21 Range 16W

Well No. #2 Morris

Company Musgrove Petroleum Company

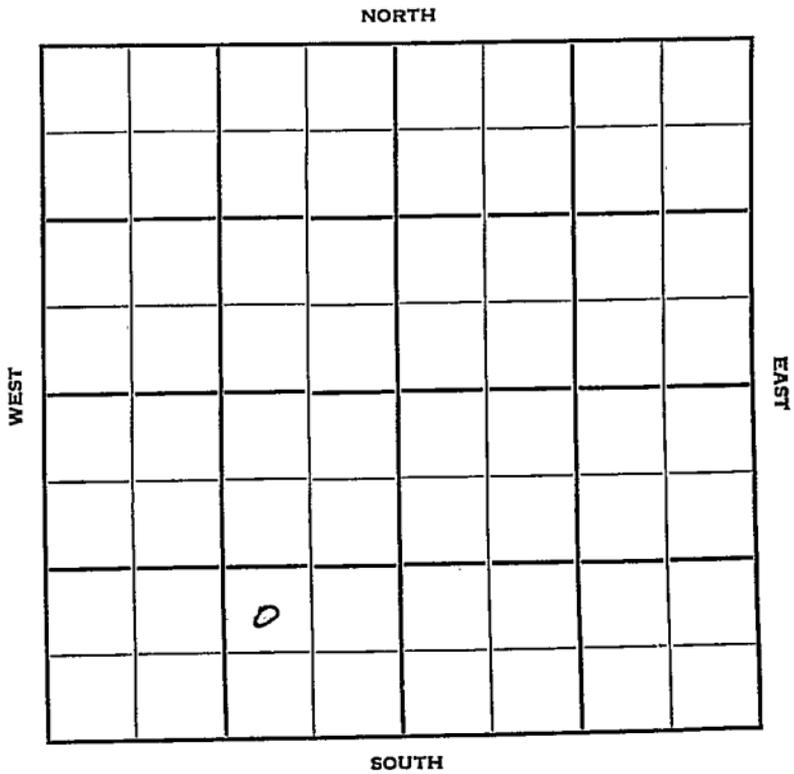

# HOT FILE

Pawnee

KANSAS ✓

Sec. 27 Twp. 21 R. 16 W

Well No. # 2 Morris Farm

Musgrove Pet. Company

Musgrove Contractor


\_\_\_\_\_ Ft. from N. Line

990 Ft. from S. Line

850 Ft. from E. Line

\_\_\_\_\_ Ft. from W. Line

NW SE SW

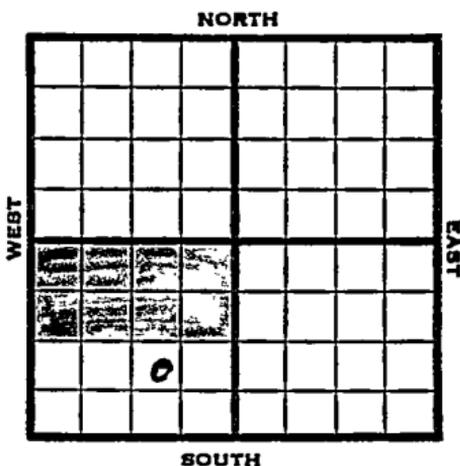

Elev. 1993 RB  
Elev. 1990 IS

## REPORT

1953

3/18

Spud 3-14-53  
8" @ 982  
Drlg. 2056'

3/26

Drlg. 3636' (Ltr)

4/2

Heeb 3383, Tor 3401, Br Li 3482,  
Lans 3491, BKC 3727, Cong 3776, Arb  
3846  
RTD 3848  
5" @ 3848'

4/10

Cleaning out. (Ltr)

4/16

GO & DD to 3852' FU 440' oil in  
1 hr. S/14 BOPH "

4/22

Spud 3-14-53  
Oil Well  
TD 3852  
8" @ 982  
Heeb 3383, Tor 3401, Br lime 3482,  
Lans 3491, B KC 3727, Cong 3776, Arb.  
3846  
TD 3848  
5" @ 3848,  
DD 3852, FU 440' oil 1 hr.,  
S/14 boph  
Comp. 3000 bopd

*3846  
1853*

*3896  
3491  
355*

**COMPLETED**


County Pawnee State Kansas

Sec. 27 (Blk. Twp.) 21 (Sur. Rge.) 16W Map No.

Operator Musgrove Pat.

Well No. 2 Farm Morris

Elev. \_\_\_\_\_ Location NW SE SW

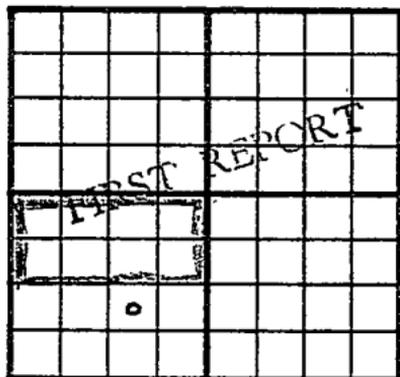

990 Ft. From S Line SW

850 Ft. From E Line Quarter

1st. Report MAR 18 1953

Completion \_\_\_\_\_

Remarks \_\_\_\_\_


Musgrove - Contr.

Spudding Date 3-14-53

Drlg. Data

8" @ 982 drlg. 2056

County Pawnee State Kansas  
 Sec. 27 (Blk. 21) (Sur. 16W) (Twp.) (Rge.) Map No.  
 Operator Musgrove Pet.  
 Well No. 2 Farm Morris  
 Elev. 1993 RB Location NW SE SW  
1990 LS

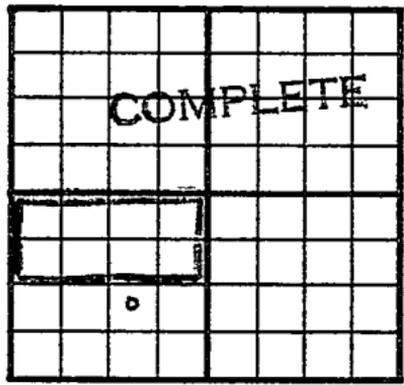

990Ft. From S Line SW  
850Ft. From E Line Quarter  
 1st. Report \_\_\_\_\_  
 Completion APR 22 1953  
 Remarks \_\_\_\_\_  
Musgrove - Contr.  
 Spudding Date 3-14-53

Drlg. Data Oil well TD 3852  
8" @ 982 Heeb. 3383 Tor. 3401  
Br. lime 3482 Lans. 3491 B KC 3727  
Cong. 3776 Arb. 3846 TD 3848  
5" @ 3848 . DD 3852 EU 440' oil 1 hr.  
S/ 14 boph Comp. 3000 bopd