

DRILLING WELL COMPLETION REPORT

Well No. 4 Farm Name J. B. Cossman

Date completed June 19, 1953

Description N $\frac{1}{2}$ SW $\frac{1}{4}$ Section 27-21S-16W


Initial production 300 bbls. Total depth 3,867 feet

Initial volume _____ cu. ft. _____ lbs. rock pressure

M.C.P.C. Interest 100%

Remarks: Allowed 68 Bbls.

ag. Lewis

W


- Mr. McDowell
- Accounting Dept. 3
- ✓Scouting Dept.
- Geological Dept.
- Pipe Line Dept.
- Materials Dept.
- Rental Dept.
- Legal Dept.
- Mr. Leo Meyer
- Income Tax Dept.
- Engineering Dept.
- Lease Inventory
- File

LOCATION NOTICE

TULSA, OKLA., May 26, 1953 19.....

WELL NO. 1 ON J. B. Gossman FARM

WILL BE AS FOLLOWS:

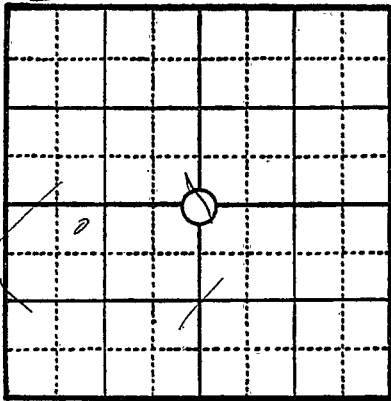

..... 330 FEET FROM NORTH LINE
 FEET FROM EAST LINE
 FEET FROM SOUTH LINE
 1140 FEET FROM WEST LINE

IN N/2 SW/4 SEC. 27 TWP. 21S RANGE 16W
Pawnee COUNTY, STATE OF Kansas

71 & 71W Sec

REMARKS: R. L. Mankey; R. O. Robey

M.C.P.C. -- 100%

SIGNED A. E. Pierce

W

COPIES TO

- R. W. McDOWELL
- DISTRICT SUPT.
- ACCOUNTING DEPT.
- SCOUTING DEPT.
- GEOLOGICAL DEPT.
- PIPE LINE DEPT.
- MATERIALS DEPT.
- RENTAL DEPT.
- LEGAL DEPT.
- LEO MEYER
- INCOME TAX DEPT.
- ENGINEERING DEPT.
- LEASE INVENTORY
- CLAIM DEPT.
- J. W. BASORE
- FILE

*CARD TYPED
 6/2/53 G.B.*