


LOCATION NOTICE

TULSA, OKLA., Jan. 16, 1953, 19.....

WELL NO. 1 ON J. B. Cossman FARM

WILL BE AS FOLLOWS:

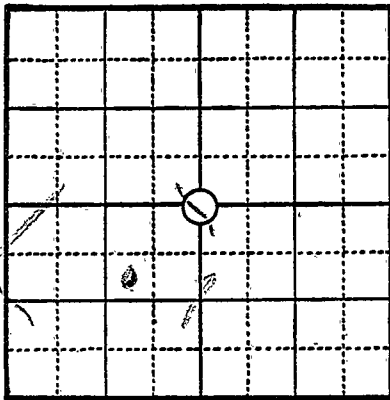

..... 990 FEET FROM NORTH LINE
 990 FEET FROM EAST LINE
 FEET FROM SOUTH LINE
 FEET FROM WEST LINE
75 Acres, N/2 SW 1/4 less that part North & West
of ATSF Ry.
 IN SEC. 27 TWP. 21S RANGE 16W
 Pawnee COUNTY, STATE OF Kansas

REMARKS: R. L. Mankey; R. O. Bobey
H. C. P. G. 100%

SIGNED A. E. Pierce

COPIES TO

- R. W. McDOWELL
- DISTRICT SUPT.
- ACCOUNTING DEPT.
- ✓ SCOUTING DEPT.
- GEOLOGICAL DEPT.
- PIPE LINE DEPT.
- MATERIALS DEPT.
- RENTAL DEPT.
- LEGAL DEPT.
- LEO MEYER
- INCOME TAX DEPT.
- ENGINEERING DEPT.
- LEASE INVENTORY
- CLAIM DEPT.
- J. W. BASORE
- FILE

Card Typed - mmm

SW 1/4 SW