

KANSAS

Finney


Section 27 Township 21 Range 34WWell No. 1 FeeCompany J E Ely

Hugoton

NORTH

WEST

EAST

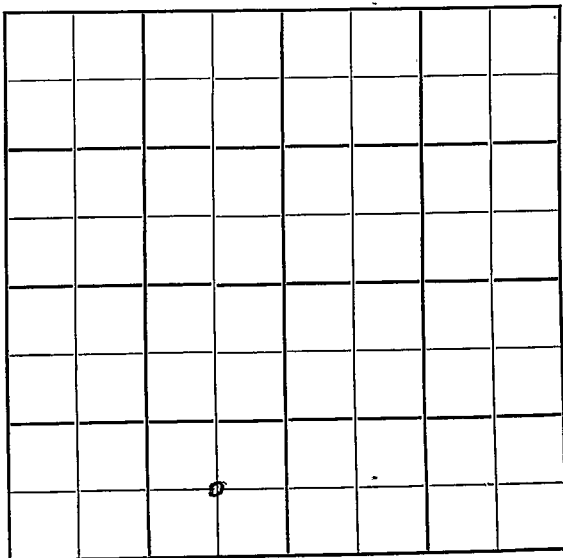

SOUTH

KANSAS

Sec. 27 Twp. 21 R. 34W

Well No. #1 Fee Farm

J. E. Ely

Company


Hugoton Pool

 Ft. from N. Line

660' Ft. from S. Line

660' Ft. from E. Line

 Ft. from W. Line

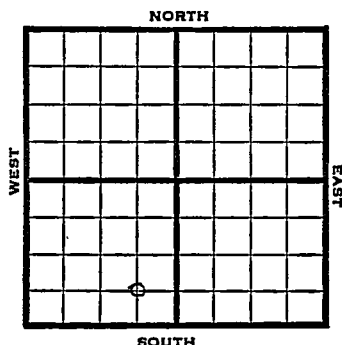

C SE SW

1949

Elev

REPORT

5/4 Location

5/10 10" @ 243'

5/18 Drlg 2300'

5/25 DST 2305-20 opn 3/4 hr

Rec 30' oil cut mud

Drlg. 2415'

6/1 TD 4362'

5" @ 4361'

6/7 TD 4730'

6/15 Miss 4624'

Swb 1 bbl oil PH

1000 acid

6/21 "

6/28 4000 acid

7/6 TD 4730'

Miss 4624'

5" @ 4627'

64 shots 4294-4310

4000 acid

Pump 543 Oil

36° Gr.

Comp

COMPLETED

Map No. _____ Sec. 27 Twp. _____ R. _____

Well No. 1 Fee _____

J. E. Ely _____ Company

FIRST REPORT

_____ Contractor

C SE SW

SECTION PLAT

_____ Ft. from N. Line

660 _____ Ft. from S. Line

660 _____ Ft. from E. Line

_____ Ft. from W. Line

Finney County

RECORD

Location X

Cased _____ in. _____ ft.

Rig up _____

Sand _____

Drilling and Remarks:

Gas _____

Oil _____

Total Depth _____

PRODUCTION

1st 24 hrs. Nat. _____

1st 24 hrs. after shot _____

Gas _____ Cu. Ft.

Dry Hole _____

Abandoned _____

Date

MAY 4 1949 19

S. J. LEWIS

Scout

Kansas

Map No. 1 Sec. 27 Twp. 21 R. 34WWell No. 1 Fee

J. E. Eley


Company

COMPLETE

Contractor

C SE SW

SECTION PLAT

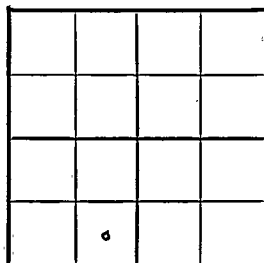 Ft. from N. Line660 Ft. from S. Line660 Ft. from E. Line Ft. from W. Line

Finney County

Location Rig up

Drilling and Remarks:

*Misc 4624**5" @ 4627**692 Lb to 4294-4310**4000 acid**Run 5490 ft**36 c/c*

RECORD

Cased in., ft.Sand Gas Oil Total Depth 4230

PRODUCTION

1st 24 hrs. Nat. 1st 24 hrs. after shot Gas Cu. Ft. Dry Hole Abandoned

Date

JUL 6 1949 19

S. J. LEWIS Scout