


KANSAS Finney

Section 27 Township 21 Range 34W

Well No. 2 Fee

Company J E Ely

Hugoton
NORTH

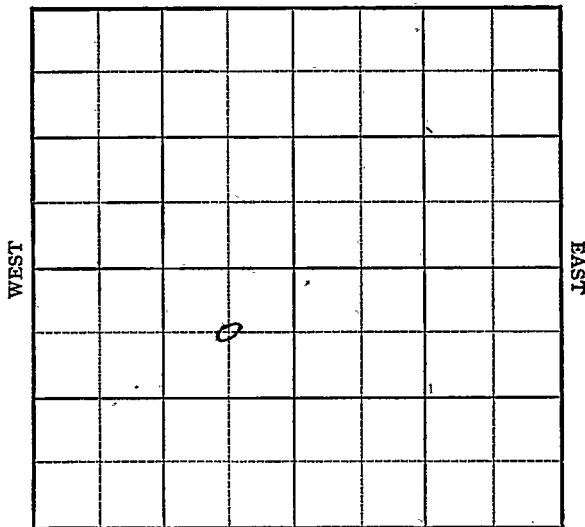

SOUTH

KANSAS

Finney

✓ 34W

Sec. 27 Twp. 21 R. 34W

Well No. #2 Fee Farm _____
J. E. Ely


Hugoton Pool (Harber Drlg., Cont.) Company _____
NORTH

660' Ft. from N. Line

_____ Ft. from S. Line

660' Ft. from E. Line

_____ Ft. from W. Line

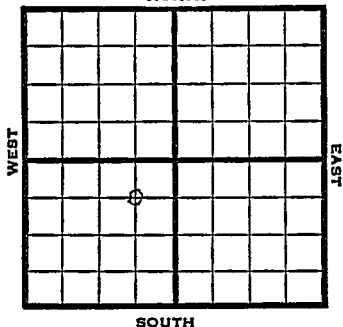

C NE SW

1949 Elev. 2957' REPORT

5/25 Location
6/1 10" @ 241'
6/7 Drlg 3280'
6/15 Drlg 4360'
6/21 "
6/28 5" @ 4618'
Drlg 4680'
7/6 "
7/12 TD 4727'
Plug 4305'
7/20 "
7/27 Sd 4298'
5" @ 4618'
57 shots 4292-4306
Acid 15,000
Pump 426 oil Pot.
Gr. 27°
TD 4277'

COMPLETED

Map No. _____ Sec. 27 Twp. 21 R. 34W

Well No. 2 Fee

J. E. Ely Company

Harbar Contractor

C NE SW

**FIRST REPORT
SECTION PLAT**

660 Ft. from N. Line

_____ Ft. from S. Line

660 Ft. from E. Line

_____ Ft. from W. Line

	o		

Finney County

Location _____ X

Rig up _____

Drilling and Remarks:

RECORD

Cased _____ in., _____ ft.

Sand _____

Gas _____

Oil _____

Total Depth _____

PRODUCTION

1st 24 hrs. Nat. _____

1st 24 hrs. after shot _____

Gas _____ Cu. Ft.

Dry Hole _____

Abandoned _____

Date

MAY 25 1949 19

S. J. LEWIS Scout

Hugoton Pool

Map No. Sec. 27 Twp. 21R 34W

Well No. 2 Fe¹

J. E. Ely Company

COMPLETE

Contractor

C NE SW

E 12957
SECTION PLAT

	o		

660 Ft. from N. Line

 Ft. from S. Line

660 Ft. from E. Line

 Ft. from W. Line

Finney County

Location

Rig up

Drilling and Remarks:

*Worm #298
5-246/8
57 shot to 4292-4306
15000 acid
Pump 426 oil Prod
27 lbs*

RECORD

Cased in., ft.

Sand

Gas

Oil

Total Depth 4277

PRODUCTION

1st 24 hrs. Nat.

1st 24 hrs. after shot

Gas Cu. Ft.

Dry Hole

Abandoned

Date

JUL 27 1949 19

S. J. LEWIS Scout