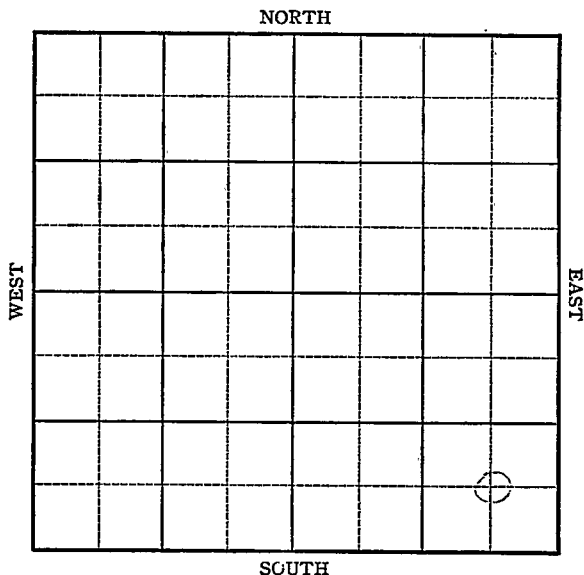


KANSAS

Finney County

Section 27 Township 21 Range 34WWell No. #2 Gobleman "A"Company Atlantic

KANSAS Finney County

Sec. 27 Twp. 21 R. 34W

Well No. #2 Gobleman "A" Farm

Atlantic Company

Nunn


         Ft. from N. Line

660 Ft. from S. Line

660 Ft. from E. Line

         Ft. from W. Line

NORTH

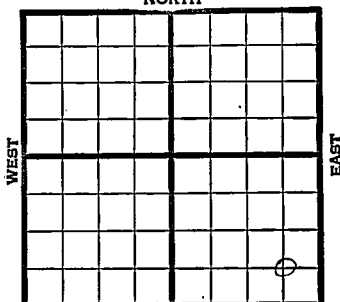

SOUTH

C SE SE 294W

1945

REPORT

3/28 10" @ 288' WOC

4/5 Drlg. 2860

4/12 Drlg. 3775

4/20 Drlg. 4536

4/27 Miss 4619-4638 TD

5" @ 4634' RUST

5/3 " " " "

5/10 " " " "

5/17 " " " "

5/24 TD 4703 2000' oil 8 hrs.

5/31 Pump 5 oil per hr. 24 hrs.

6/13 Miss 4619

5" @ 4634'

8000 acid

Pump 829 Pot.

31 0 Gr.

TD 4703'

**COMPLETED**

Pool Name NunnMap No. No Map Sec. 27 Twp. 21 R. 34WWell No. 2 Gobleman "A"Atlantic

Company

FIRST REPORT

Contractor

C SE SE

## SECTION PLAT

|  |  |  |   |
|--|--|--|---|
|  |  |  |   |
|  |  |  |   |
|  |  |  |   |
|  |  |  | o |

         Ft. from N. Line660 Ft. from S. Line660 Ft. from E. Line         Ft. from W. LineFinneyLocation         Rig up         

Drilling and Remarks:

10"-288 WOC

## RECORD

Cased          in.          ft.Sand         Gas         Oil         Total Depth         

## PRODUCTION

1st 24 hrs. Nat.         1st 24 hrs. after shot         Gas          Cu. Ft.Dry Hole         Abandoned         

Date

MAR 2 8 194519S. J. LEWIS

Scout

Kansas Pool Name NunnMap No. 1120 *Mc* Sec. 27 Twp. 21 R. 34WWell No. 2 Gobleman "A"Atlantic

Company

**COMPLETED**

Contractor

C SE SE

*E12948*  
SECTION PLAT         Ft. from N. Line660 Ft. from S. Line660 Ft. from E. Line         Ft. from W. Line

|  |  |  |  |
|--|--|--|--|
|  |  |  |  |
|  |  |  |  |
|  |  |  |  |
|  |  |  |  |

Finney CountyLocation         Rig up         

Drilling and Remarks:

*Miss 4619**5" @ 4634**8000 Quads**Pump 529 BT**31 1/2***RECORD**Cased          in.,          ft.Sand         Gas         Oil         Total Depth 4783**PRODUCTION**1st 24 hrs. Nat.         1st 24 hrs. after shot         Gas          Cu. Ft.Dry Hole         Abandoned         

Date

JUN 13 1945

19

S. J. LEWIS

Scout