


Section 27 Township 21 Range 34-W

Well No. 1 Gobelmen "A"

Company Atlantic Prod.

NORTH Nunn Pool

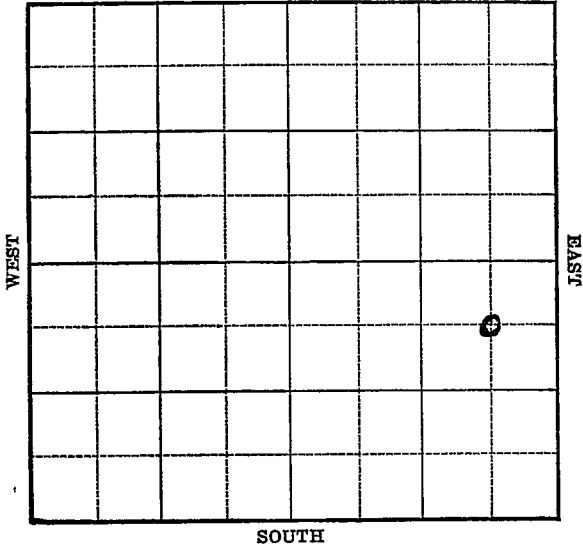

O. W. D. D.

Sec. 27 Twp. 21 R. 34-W

Well No. #1 Gobelmen Farm
Atlantic Prod. Company


(Nunn)

660 Ft. from N. Line

_____ Ft. from S. Line

660 Ft. from E. Line

_____ Ft. from W. Line

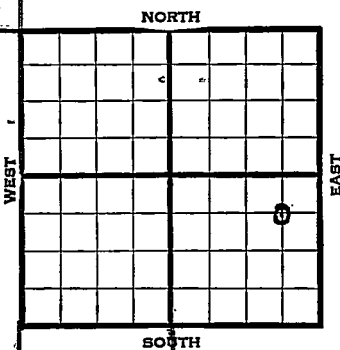

Elev. 2957'

1939	REPORT
5/3	Building rotary.
5/12	Rigging up.
5/19	12" - 258' Drlg. 2213'
5/26	Dakota 535' Anhy. 2010'
	Lans. 3870' S.O. 4016-17'
	Will core.
6/1	Lans. 3890' S.O. 4016-17'
	Drlg. 4540'
6/8	Core 4046-55'
	Sat. Miss. 4652
	Core 4655-59'
	T.D. 4679' 5" @ 4652'
6/16	1000 acid. No test.
6/23	Bail 10 gals. per hour.
	Shot 20 qts. 3000 acid.
	Swab 6 to 10 bbls. per hour.
6/29	9000 acid. Pump 214 bbls. 14 hrs.
	OVER

1939

7/5 Miss. 4652'
5" - 4652'
T.D. 4679'
13,000 acid.
Echometer potential 1724 bb1s.

COMPLETED

1944 O. W. D. D.

3/8 Miss. 4652'
D.T.D. 4679
5" @ 4652
Old Pot. 1724 *
Drill Deeper

3/15 Drlg. 4755 inc oil.

3/22 4755 TD
PB 4688
6000 acid.

3/29 PB 4688
6000 acid
TD 4755
Miss. 4652
Pump 60 Pot
Gravity 31.0

COMPLETED

Map No. NM Sec. 27 Twp. 21 R. 34WWell No. 1 GobelmenAtlantic Prod.

Company

Contractor

FIRST REPORT**SECTION PLAT***660 **C NE SE**
Ft. from N. Line

____ Ft. from S. Line

660 Ft. from E. Line

____ Ft. from W. Line

			o

NUNN POOL

Location _____

Rig up _____

Drilling and Remarks:

Building Roty.**RECORD**

Cased _____ in., _____ ft.

Sand _____

Gas _____

Oil _____

Total Depth _____

PRODUCTION

1st 24 hrs. Nat. _____

1st 24 hrs. after shot _____

Gas _____ Cu. Ft.

Dry Hole _____

Abandoned _____

Date

MAY 3 1939

19

Scout

Map No. 111 Sec. 27 Twp. 21 R. 34W

Well No. 1 Gobelmen

Atlantic Production

Company

Contractor

COMPLETED

C NE SE

660 Ft. from N. Line

_____ Ft. from S. Line

660 Ft. from E. Line

_____ Ft. from W. Line

SECTION PLAT

			o

NUMN POOL

Location _____

RECORD

Cased _____ in., _____ ft.

Sand _____

Gas _____

Oil _____

Total Depth 4679

PRODUCTION

1st 24 hrs. Nat. _____

1st 24 hrs. after shot _____

Gas _____ Cu. Ft.

Dry Hole _____

Abandoned _____

Drilling and Remarks:

*Miss 4652.
5" C 4652.
18000 acid
Echometer P.S.
1724*

Date

JUL 5 1939 19

S. J. LEWIS

Scout

Finney

Map No. KANSAS NM Sec. 27 Twp. 21 R. 34W

Well No. 1 Gobleman "A"

Atlantic Company

COMPLETED Contractor

C NE SE

SECTION PLAT

660 Ft. from N. Line

_____ Ft. from S. Line

660 Ft. from E. Line

_____ Ft. from W. Line

			6

Nunn Pool

Location _____

Rig up _____

Drilling and Remarks:

*Well 4652
 PB 4688
 6000 acid
 Pump 60 P.F.
 3/9/44*

RECORD

Cased _____ in., _____ ft.

Sand _____

Gas _____

Oil _____

Total Depth 4250

PRODUCTION

1st 24 hrs. Nat. _____

1st 24 hrs. after shot _____

Gas _____ Cu. Ft.

Dry Hole _____

Abandoned _____

Date

MAR 29 1944 19

S. J. LEWIS Scout