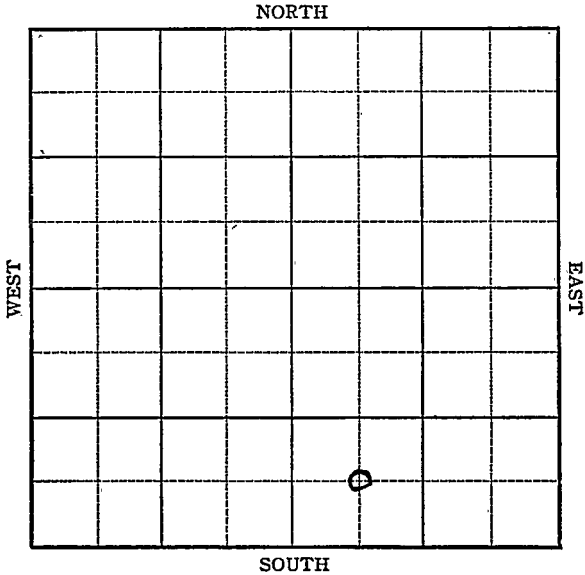


KANSAS

FORM 51 5M 6-46 PETROL

Section 27 Township 21 Range 34-WWell No. #4, Gobleman "A"Company Shallow Water Refg.

O.W.W.O.

Sec. 27 Twp. 21 R. 34WWell No. #4 Gobleman "A" Farm


Shall Water Ref. _____ Company

Shallow Water

_____ Ft. from N. Line

660 Ft. from S. Line

_____ Ft. from E. Line

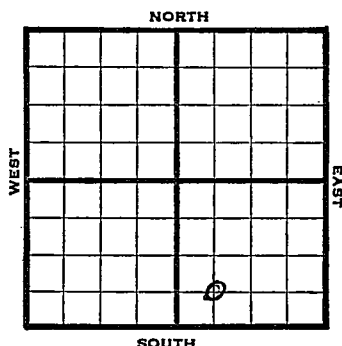660 Ft. from W. Line

C SW SE

REPORT

1946 Elev. 2952'

8/28 Location

9/5 10" @ 205 WOC

9/10 Herrington 2 504'

Drlg 2560'

9/18 Krester 2577'

Drlg 2650'

9/24 Drlg 3191'

10/1 Drlg 4667'

10/8 Lans 3950'

Miss 4637

TD 4698'

5" @ 4650 RUST

10/15 " "

10/22 TD 4705

1400' oil

4000 acid, fsg

10/29 " "

11/6 Pump 166 oil in 21 hrs

11/13 Miss 4596'

5" @ 4654'

4000 Acid

Pump 420 POT

TD 4705'

37 Grav.

COMPLETED

OVER

1950
10/18 72/4278-90 O.W.W.O.

SP 4320

1000 A

S/90 bo 24 hr

3000 A

11/1 72/4278-90

SP 4320

1000 A S/90 bo 24 hr

3000 A

Marmaton 4278

Comp 95 bopd

Completed

COMPLETED

KANSAS Kansas Pool Name Shallow WaterMap No. _____ Sec. 27 Twp. 21 R. 34WWell No. 4 Gobleman "A"Shallow Water Ref. Company _____

FIRST REPORT

Contractor _____


C SW SE

SECTION PLAT

_____ Ft. from N. Line

660 Ft. from S. Line

_____ Ft. from E. Line

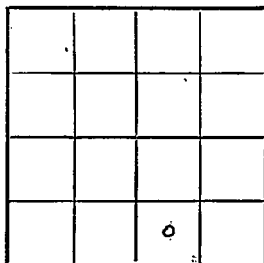660 Ft. from W. LineFinney CountyLocation X

Rig up _____

Drilling and Remarks:

RECORD

Cased _____ in., _____ ft.

Sand _____

Gas _____

Oil _____

Total Depth _____

PRODUCTION

1st 24 hrs. Nat. _____

1st 24 hrs. after shot _____

Gas _____ Cu. Ft.

Dry Hole _____

Abandoned _____

Date

AUG 28 1946 19S. J. LEWIS

Scout

KANSAS
Kansas

Shallow Water

Map No. _____ Sec. 27 Twp. 21 R. 3 4WWell No. 4 Gobleman "A"

Shallow Water Ref. _____ Company _____

COMPLETED

Contractor _____

C SW SE

E. 295.2
SECTION PLAT

_____ Ft. from N. Line

660 Ft. from S. Line

_____ Ft. from E. Line

660 Ft. from W. Line

		o	

Finney County

Location _____

Rig up _____

Drilling and Remarks:

*Miss 4596**5" @ 4654**4000 acid**Runny 420 P.T.**37° E***RECORD**

Cased _____ in., _____ ft.

Sand _____

Gas _____

Oil _____

Total Depth 4725**PRODUCTION**

1st 24 hrs. Nat. _____

1st 24 hrs. after shot _____

Gas _____ Cu. Ft.

Dry Hole _____

Abandoned _____

Date

NOV 13 1946 19

S. J. LEWIS

Scout

County Finney State Kans23
 Sec. 27 (Blk. Twp.) 21 (Sur. Rge.) 34W Map No.
 Operator Shallow Water Ref.
 Well No. 4 Farm Gobleman
 Elev. _____ Location C SW SE


FIRST REPORT

660 Ft. From S Line SE
660 Ft. From W Line Quarter
 1st. Report OCT 18 1950
 Completion 11/1
 Remarks OWWO
 Spudding Date _____

Drlg. Data Hugoton Pool
72/ 4278-90 SP 4320 1000 A S/ 90 bo
24 hr. 3000 A

J. E. TYRA

County Finney State Kansas
 Sec. 27 (Blk.) 21 (Sur.) 34W Map No.
 Operator Shallow Water Refining Co.
 Well No. 4 Farm Gobleman
 Elev. Location C SW SE

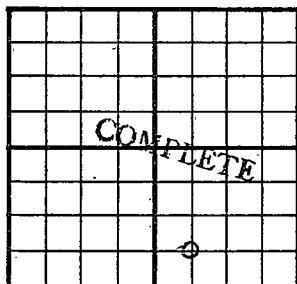

660 Ft. From S Line SE

660 Ft. From W Line Quarter

1st. Report

Completion NOV 1 1950

Remarks OWWO

Hugoton Pool

Spudding Date

Drlg. Data Oil well
72/ 4278-90 SP 4320 1000 A S/ 90 bo
24 hr. 3000 A Marmaton 4278
Comp. 95 bopd

J. E. TYRA