


Section 27 Township 21 Range 34-W

Well No. 1 Nunn

Company Atlantic Refining

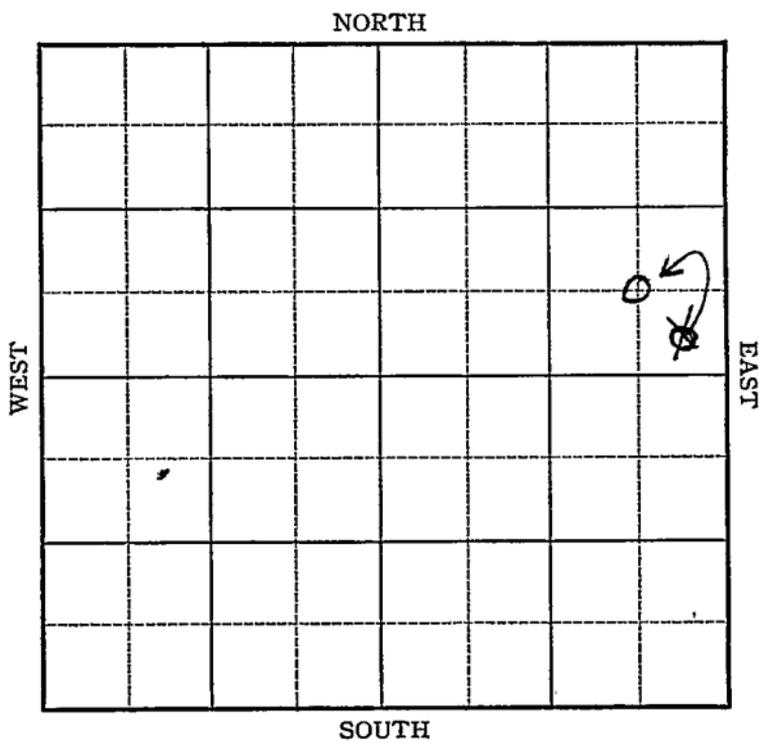

O. W. D. D

Sec. 27 Twp 21 R. 34-W

Well No. #1 Farm

Atlantic Refining Company

Ft. from N. Line

~~330~~
660


Ft. from S. Line

~~330~~
660

Ft. from E. Line

Ft. from W. Line

Elev. 2961

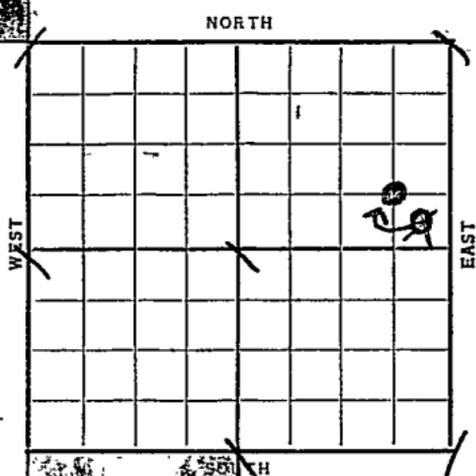

Date

REPORT

O. W. D. D

1938

1/26

Location

2/2

Rotary rig.

2/4

R.R.

2/11

"

2/18

"

2/26

Mat.

3/4

13" @ 234'. Drlg. 1000'.

3/11

Anhy 2040'. Drlg. 3040'.

3/18

Drlg. 3831'.

3/25

Lans. 3905'. S.O. 4297-4300'.

T.D. 4311'. Pipe stuck.

4/1

T.D. 4311' Fsg.

4/8

" " "

4/15

P.B. 1890'. Cementing whipstock

4/22

Drlg. 2200'.

4/29

Drlg. 3157'.

5/6

Drlg. 4041'.

5/12

Drlg. 4457'.

OVER

- 5/16--Cored 4627-37
Recovered 5' dense lime, 2' shale,
1 foot tight lime, and 2 feet oolitic
lime Had saturation in last 2 feet
Cored 4642-47--no report on recovery
May take drill stem test
(This well in Mississippi series) (Tel)
- 5/20 Miss. 4616'. S.S.O. 4628-29 &
4636-38'. Cored 4653-63' T.D.
Rec. 5' of sat. sand.
7" @ 4632'. WOC.
- 5/27 Drlg. plug.
- 5/28--Drilled plugs No oil or gas
Will drill ahead (Tel)
- 5/31--Will shoot and acidize. (Tel)
- 6/3 Shot 60 qts. 4637-53'.
Cleaning out.
- 6/9--T.D. 4667 Acidized 6000 gallons
1200 feet oil hole Swabbing 7 bbls. oil
per hour Trace water Think acid water
Does not lower fluid level (Tel)
- 6/13--Acidized 6000 Gallons
Swabbed 172 Barrels in 5 hours
Swabbing 300 feet off bottom (No Water)
- 6/14--Swab 265 bbls. oil in 12 hrs.
Gravity 28.
Running tubing & rods to pump. (Tel)

OVER



1938

6/22

7" at 4632'.
 Miss. 4616'.
 T.D. 4667'.
 Shot 60 qts.
 Shot 20 qts.
 8000 acid.
 Pump 101 bbls. 4 hrs. &
 101 bbls. 4 hrs.
 Potential 604 bbls.
 Plus 2% water.
 28.9 Gravity.

COMPLETED

1938

O. W. D. D

9/28

Old T.D. 4667'.
 Miss. 4605'.
 Drlg. 4672'.
 No Increase.

10/7

T.D. 4690'. Swabbing 11 oil P.H.

10/14

T. D. 4718'. Swab 126 oil in
 6 hrs. 30 shots 4608-23'.
 Swab 139 oil 12 hrs.

OVER

1938

10/29 Miss. 4605'.

T. D. 4718'.

30 shots 4608-23'.

Pump 201 oil in 24 hrs.

Comp. for old potential of 604
barrels.

COMPLETED

Finney

KANSAS

Map No. AM Sec. 27 Twp. 21 R. 34WWell No. 1 Nunn

Atlantic Ref.


Company

Contractor

FIRST REPORT
SE NE Ft. from N. Line330 Ft. from S. Line330 Ft. from E. Line Ft. from W. Line

Special

SECTION PLAT

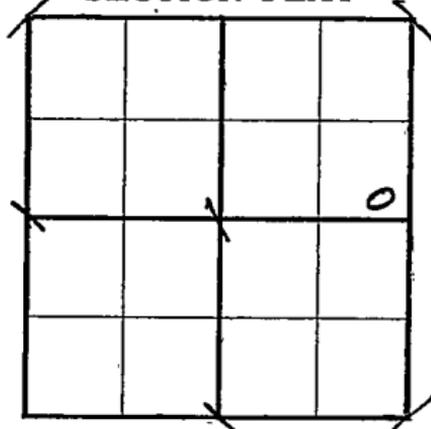Location XRig up Drilling and Remarks:

RECORD

Cased in., ft.Sand Gas Oil Total Depth

PRODUCTION

1st 24 hrs. Nat. 1st 24 hrs. after shot Gas Cu. Ft.Dry Hole Abandoned

Date

JAN 26 1938

19

H. D. Hatfield Scout

Timney **KANSAS**

Map No. *NM* Sec. *27* Twp. *21* R. *34W*

Well No. *1 - Mann*

Atlantic Ref. Company
Contractor

CORRECTION

SECTION PLAT

_____ Ft. from N. Line
660 Ft. from S. Line
660 Ft. from E. Line
_____ Ft. from W. Line

			<i>05</i>

Location _____

Rig up _____

Drilling and Remarks:

*first Reported
Gas se ve
Changed to
C se ve*

RECORD

Cased _____ in., _____ ft.
Sand _____
Gas _____
Oil _____
Total Depth _____

PRODUCTION

1st 24 hrs. Nat. _____
1st 24 hrs. after shot _____
Gas _____ Cu. Ft.
Dry Hole _____
Abandoned _____

Date

FEB 9 1938

H. D. Hatfield

19

Scout

Finney KANSAS

Map No. MM Sec. 27 Twp. 21 R. 34W

Well No. 1 Nunn

Atlantic Refining

Company

Contractor

COMPLETED

C SE NE

_____ Ft. from N. Line

660 Ft. from S. Line

660 Ft. from E. Line

_____ Ft. from W. Line

SECTION PLAT

			O

Location _____

Rig up _____

Drilling and Remarks:

*Shot 60 gts
- 20 ✓*

8000 acid

Pump 10 1/4 4 10 1/4

POT 604

plus 290 wt

Date *Jan 28.9*

JUN 22 1938

19

RECORD

Cased 7 in., 4632 ft.

Sand MISS 4616

Gas _____

Oil _____

Total Depth 4667

PRODUCTION

1st 24 hrs. Nat. _____

1st 24 hrs. after shot _____

Gas _____ Cu. Ft.

Dry Hole _____

Abandoned _____

H. D. Hatfield Scout

Map No. MM Sec. 27 Twp. 21 R. 34WWell No. 1 NummAtlantic

Company

Contractor

FIRST REPORT

C SE NE

SECTION PLAT

			0

_____ Ft. from N. Line

660 Ft. from S. Line660 Ft. from E. Line

_____ Ft. from W. Line

Location _____

Rig up _____

Drilling and Remarks:
OWDD-OTD 4667Miss. 4605Drlg. 4672No Increase

RECORD

Cased _____ in., _____ ft.

Sand _____

Gas _____

Oil _____

Total Depth _____

PRODUCTION

1st 24 hrs. Nat. _____

1st 24 hrs. after shot _____

Gas _____ Cu. Ft.

Dry Hole _____

Abandoned _____

Date

SEP 28 1933 19H. D. Hatfield Scout

Map No. VM Sec. 27 Twp. 21 R. 34WWell No. 1 NunnAtlantic

Company

Contractor

COMPLETED

SECTION PLAT

			0

C SE NE

_____ Ft. from N. Line

660 Ft. from S. Line660 Ft. from E. Line

_____ Ft. from W. Line

OWDD —

Location _____

Rig up _____

Drilling and Remarks:

30 shots 4608-23Pump 201 oil in
24 hrsComp. For old
pot of 604 bbls

RECORD

Cased _____ in., _____ ft.

Sand MISS 4605

Gas _____

Oil _____

Total Depth 4718

PRODUCTION

1st 24 hrs. Nat. _____

1st 24 hrs. after shot _____

Gas _____ Cu. Ft.

Dry Hole _____

Abandoned _____

Date

OCT 19 1938H. D. Hatfield Scout