KANSAS


FORM 51 5M BRIX

Finney County

Section 27 Township 21 Range 34W

Well No. #2 Nunn

Company Atlantic

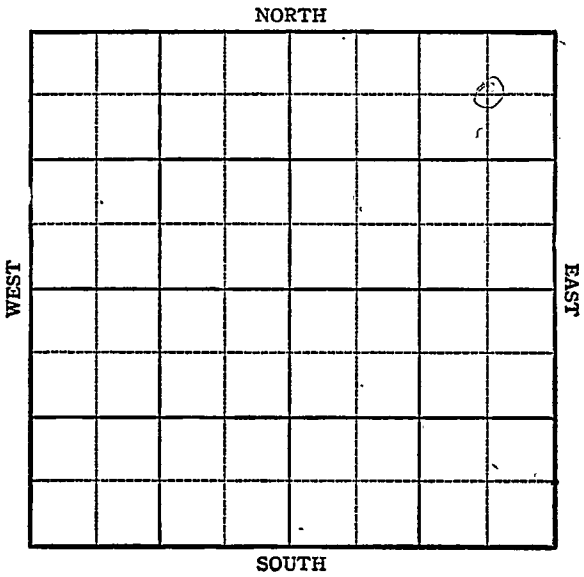

FORM 252-A
5M 9-43 GASS

KANSAS

Finney County

Sec. 27 Twp. 21 R. 34W

Well No. # 2, Nunn Farm

Atlantic Company


Nunn

660 Ft. from N. Line

Ft. from S. Line

660 Ft. from E. Line

Ft. from W. Line

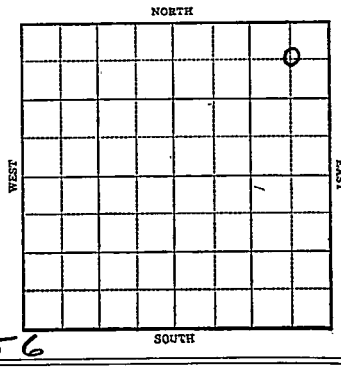

Elev. 2956

1944	REPORT
7/5	Derrick
7/12	10" @ 261 Drlg 2605
7/19	Drlg 3225
7/26	Drlg. 4142
8/2	Drlg. 4607
	Lans 3848
8/9	Miss. 4615
	Td 4704
8/16	5" @ 4616 RUST
8/23	" " " "
8/30	400' oil
9/8	2000 acid CO
9/13	" " "
9;21	" " "
9/28	" " "
10/4	TD 4708 CO
10/11	" " "
10/18	TD 4738 CO
10/25	TD 4754 7000 acid swb 8 oil in12hr
11/1	" " " " " " " "
11/8	" " " " " " " "
11/16	" " " " " " " "
11/24	Pump 134 oil 140 wtr in 24 hr.s
11/29	Miss. 4615
	5" @ 4602
	TD 4754
	7000 acid
	Pump 155 oil plus 60% BS&W POT
	Grav. 31.0

COMPLETED

FORM 26 200 BKS 1-44 PETROL.

KANSAS

Pool Name Nunn

Map No. NW Sec. 27 Twp. 21 R. 34W


Well No. 2 Nunn

Atlantic Company

FIRST REPORT Contractor

C NE NE

SECTION PLAT

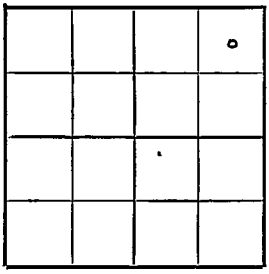

660 Ft. from N. Line

Ft. from S. Line

660 Ft. from E. Line

Ft. from W. Line

Finney County

Location

Rig up

Drilling and Remarks:

Derrick

RECORD

Cased in., ft.

Sand

Gas

Oil

Total Depth

PRODUCTION

1st 24 hrs. Nat.

1st 24 hrs. after shot

Gas Cu. Ft.

Dry Hole

Abandoned

Date

JUL 5 1944 19 S. J. LEWIS Scout

FORM 56 200 BKS. 1-44 PETROL

Pool Name Nunn Pool

Map No. N/M Sec. 27 Twp. 21 R. 34W

Well No. 2 Nunn

Atlantic Company

COMPLETED Contractor

C NE NE


660 Ft. from N. Line

Ft. from S. Line

660 Ft. from E. Line

Ft. from W. Line

SECTION PLAT

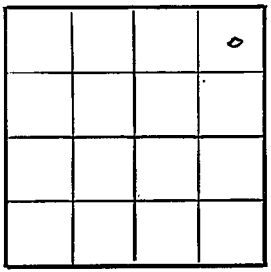

Finney

Location

Rig up

Drilling and Remarks:

Miss 4615-
5" @ 4602
7000 acid
Pmp 155 oil +60%
BS+W. BS+
31° Gr.

RECORD

Cased in., ft.

Sand

Gas

Oil

Total Depth 4254

PRODUCTION

1st 24 hrs. Nat.

1st 24 hrs. after shot

Gas Cu. Ft.

Dry Hole

Abandoned

Date

NOV 2 9 1944 19 S. J. LEWIS Scout